

SURVEY & REMONUMENTATION

AUG 08 1997

COMMISSION

LAND CORNER RECORDATION CERTIFICATE
Filing Requirement of Act 74, Mich. P.A. 1970

Register's Office }
Gogebic County } ss.

For corners in

Gogebic
(County)

Located In:

Corner Code #

- | | | | |
|------------------------------------|-------------------|------------|-----|
| 1. Public Land Survey | <u>T47NR45W</u> | <u>0-3</u> | |
| | T ___ R ___ | ___ | ___ |
| | T ___ R ___ | ___ | ___ |
| | T ___ R ___ | ___ | ___ |
| 2. Property Controlling in Section | S ___ T ___ R ___ | ___ | ___ |
| | S ___ T ___ R ___ | ___ | ___ |
| 3. Miscellaneous Property in Sec. | S ___ T ___ R ___ | ___ | ___ |
| | S ___ T ___ R ___ | ___ | ___ |

Received for record the
13th day of MAY
A. D. 1997 at 2:05 o'clock
P m., and recorded in
Liber 6 of CORNERS
on page 113
Ramona Collins, Deputy
Register of Deeds


Register of Deeds Stamp & File Number

4. Lot No. _____, Recorded Plat _____
5. Private Claims _____

Sec. cor. comm. to sec's. 5,6,7 & 8

I, John P. Goss, in a field survey on April 23, 1997 do hereby state that under requirements of P.A. 74, Michigan P.A. of 1970, the corner points mentioned in lines 1 and 2 above were in conformance with regulations and rules therefore as required in the current manual of survey instructions of the United States Department of the Interior, Bureau of Land Management or by a decree of a Court of Law and/or that the corner points mentioned in lines 3, 4 and 5 above were in conformance with the rules of the Michigan Board of Land Surveyors or by a Decree of a Court of Law; established, re-established, monumented, recovered, found as expressed below:

NOTE: Not more than 2 corners, all in the same town and range, may be recorded on this certificate.

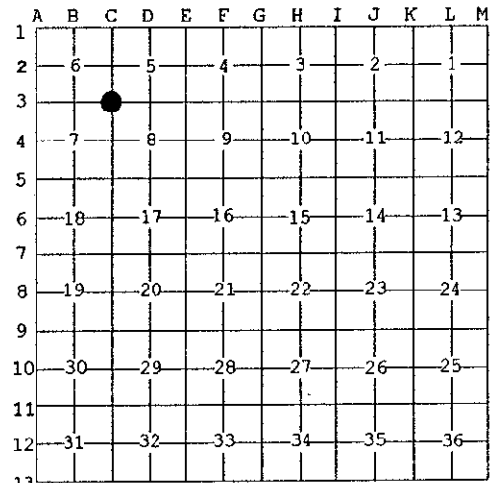

A. Description of original monument and accessories and/or subsequent restoration:
Original corner established by William Burt in 1848. Set Ironwood Post.
Original bearing trees: Sugar N 40° E 20 links
Elm S 32° W 30 links
John P. Goss, RLS, on Dec. 15, 1982, found a 3/4 inch T-Surveyor iron pin with Cap No. 17607 in rock pile. It has been used by various Surveyor's and was commonly accepted as Section Corner. I recorded said corner in Liber 2, page 318 of Land Corners for Gogebic County. I established the following reference objects: 10" Maple- S 16° W- 13.35'; 8" Oak- S 52° E- 28.27'; P.Pole- S 82° W- 26.67' from the 3/4 inch T-Surveyor iron pin.


B. Description of corner evidence found and/or method applied in restoring or reestablishing corner:
No original evidence could be found due to farming and power line operation in area.
I found the 3/4 inch T-Surveyor iron pin and it checked with the above witnesses. I updated the accessories as noted below to state and county specification.

Act 74 research on file.

C. Description of monument for corner and accessories established to perpetuate locating the position of the corner:
I replaced the 3/4" T-Surveyor iron pin with a 2 1/2" by 30" aluminum pipe with a 3 1/2" Aluminum cap stamped as follows: County Remonumentation; T 47 N, R 45 W; S-5, S-6, S-7, S-8; 1997; PS. 23509. I established the following reference objects:

- | | | |
|-----------------|---------|--------|
| 13" Maple | S 16° W | 13.35' |
| 11" Oak | S 52° E | 28.11' |
| P.Pole #7-90/93 | S 82° W | 26.67' |
| 3" White Birch | N 29° E | 95.95' |
| 6' rail & sign | N 45° W | 2.65' |

PEER GROUP APPROVAL
Richard L. Dredger 5/12/97
COUNTY REPRESENTATIVE

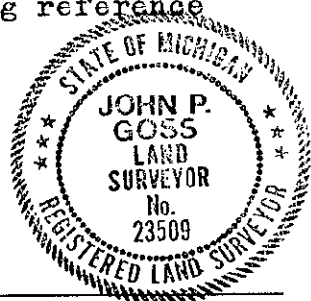

Signed by John P. Goss
Surveyor's Michigan License No. 23509

Date April 23, 1997

Fed. No. E-5