

SURVEY & REMONUMENTATION

JUN 29 1995

LAND CORNER RECORDATION CERTIFICATE
Filing Requirement of Act 74, Mich. P.A. 1970

COMMISSION
For corners in
Gogebic
(County)

	Located In:	Corner Code #
1. Public Land Survey	T <u>47N</u> R <u>45W</u>	<u>C-7</u>
	T _____ R _____	_____
	T _____ R _____	_____
	T _____ R _____	_____
2. Property Controlling in Section	S _____ T _____ R _____	_____
	S _____ T _____ R _____	_____
3. Miscellaneous Property in Sec.	S _____ T _____ R _____	_____
	S _____ T _____ R _____	_____

Register's Office }
Gogebic County } ss.

Received for record the
6TH day of MARCH
A. D. 1995 at 9:15 o'clock
A m., and recorded in
Liber 5 of CORNERS
on page 219
Ramona Collins, Deputy
Register of Deeds

Register of Deeds Stamp & File Number

4. Lot No. _____, Recorded Plat _____
5. Private Claims _____
Section corner common to Sections 17, 18, 19 and 20,
T47N, R45W

	A	B	C	D	E	F	G	H	I	J	K	L	M
2	6		5		4		3		2		1		
3													
4	7		8		9		10		11		12		
5													
6	18		17		16		15		14		13		
7													
8	19		20		21		22		23		24		
9													
10	30		29		28		27		26		25		
11													
12	31		32		33		34		35		36		
13													

I, John R. Garske in a field survey on December 23, 19 94, do hereby certify that under requirements of P.A. 74, Michigan P.A. of 1970, the corner points mentioned in lines 1 and 2 above were in conformance with regulations and rules therefore as required in the current manual of survey instructions of the United States Department of the Interior, Bureau of Land Management or by a decree of a Court of Law and/or that the corner points mentioned in lines 3, 4 and 5 above were in conformance with the rules of the Michigan Board of Land Surveyors or by a Decree of a Court of Law; established, re-established, monumented, re-monumented, recovered, found as expressed below:

NOTE: Not more than 4 corners, all in the same town and range, may be recorded on this certificate.

- A. Description of original monument and accessories and/or subsequent restoration:
- Original Survey by William Burt, 1848. Set sugar post from which a 8" sugar bears S34°E, 37 links and a 16" hemlock - N54°W, 22 links.
 - 1930 - Assessor's Plat No. 7 AKA Alquist Addition. References corner position.
 - 1948 - 5" pipe with 6" cap stamped: T47, R45; 18, 17, 19 20 - 48 monument's source unknown, most likely placed by mining company engineer.
 - 1958 - Plymouth Plat - References corner position.
 - 1981 - J. Goss found iron pipe with cap and established bearing trees: 4" maple - N12°E, 7.32 feet; 5" maple - N35°W, 22.45 feet; 4" maple - S47°E, 13.55 feet. Recorded L 2, pg. 128.


B. Description of corner evidence found and/or method applied in restoring or reestablishing corner:

I found a 5" diameter pipe with 6" diameter cast iron cap stamped as noted above. Accepted corner position and after checking into it found concrete monuments in the Plat of Assessor's No. 7 and Plymouth Plat to verify the pipe found as referenced to the above plats.

I upgraded the corner position to county specs as noted below.
Record research on file with Register of Deeds office.

PEER GROUP APPROVED
Richard L. Decker 3/1/95
COUNTY REPRESENTATIVE

- C. Description of monument for corner and accessories established to perpetuate locating the position of the corner:
- Found a 5" diameter pipe with a 6" cast iron cap stamped T47, R45; 18, 17, 19, 20 and 48 marking the corner position, I established the following bearing trees and reference objects:
- 7" oak - S62°E, 21.24 feet
 - 6" maple - S30°W, 24.23 feet
 - 9" oak - N80°W, 23.20 feet
 - 6' steel rail with sign - north - 1.80 feet

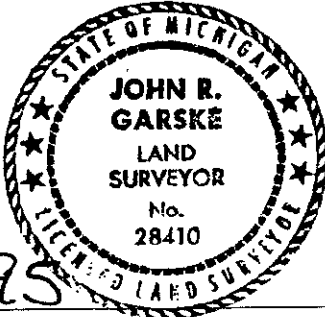

Signed by John R. Garske Date 1-17-95
Surveyor's Michigan License No. 28410