

**SURVEY & REMONUMENT**

AUG 08 1997

COMMISSION

**LAND CORNER RECORDATION CERTIFICATE**  
 Filing Requirement of Act 74, Mich. P.A. 1970

Register's Office }  
 Gogebic County } ss.

For corners in

Gogebic  
 (County)

Located In:

Corner Code #

- 1. Public Land Survey
 

<u>T47NR 45W</u>	<u>D-1</u>
<u>T48NR 45W</u>	<u>D-13</u>
T ___ R ___	___
T ___ R ___	___
- 2. Property Controlling in Section
 

S ___ T ___ R ___	___
S ___ T ___ R ___	___
- 3. Miscellaneous Property in Sec.
 

S ___ T ___ R ___	___
S ___ T ___ R ___	___

Received for record the  
11<sup>th</sup> day of JUNE  
 A. D. 1997 at 10:35 o'clock  
A m., and recorded in  
 Liber 6 of CORNERS  
 on page 140  
Callie M. Ketchak, Deputy  
 Register of Deeds

Register of Deeds Stamp & File Number

- 4. Lot No. \_\_\_\_\_, Recorded Plat \_\_\_\_\_
- 5. Private Claims \_\_\_\_\_

I, John P. Goss, in a field survey on May 20, 1997 do hereby state that under requirements of P.A. 74, Michigan P.A. of 1970, the corner points mentioned in lines 1 and 2 above were in conformance with regulations and rules therefore as required in the current manual of survey instructions of the United States Department of the Interior, Bureau of Land Management or by a decree of a Court of Law and/or that the corner points mentioned in lines 3, 4 and 5 above were in conformance with the rules of the Michigan Board of Land Surveyors or by a Decree of a Court of Law; established, re-established, monumented, recovered, found as expressed below:

NOTE: Not more than 2 corners, all in the same town and range, may be recorded on this certificate.

1/4 cor. comm. to sec's 5 & 32

	A	B	C	D	E	F	G	H	I	J	K	L	M
1				●									
2	6			5		4		3		2			1
3													
4	7			8		9		10		11			12
5													
6	18			17		16		15		14			13
7													
8	19			20		21		22		23			24
9													
10	30			29		28		27		26			25
11													
12	31			32		33		34		35			36
13				●									

A. Description of original monument and accessories and/or subsequent restoration:  
 Original corner established by Austin Burt in 1847. Set a post.  
 original bearing trees: Hemlock 20" N 50° E 10 links  
 Hemlock 12" N 64° W 10 links  
 On April 5, 1963, Donald Lappala, RLS, recovered 2 large decayed hemlock stumps at record bearing and distance also found line tree stump. He set a 2" iron pipe with 3" bronze table, indicated the corner position and recorded said corner in Forest Service Record book in Register of Deeds Office for Gogebic County. He established the following bearing trees: 13" Red Maple - N 18° W - 28.2'; 6" Red Maple - N 52° E - 26.2'; 14" Sugar Maple - S 37° W - 16.1'.

B. Description of corner evidence found and/or method applied in restoring or reestablishing corner:  
 Recovered the following original bearing trees: a large decayed hemlock stump at N 50° W- 10 links; at N 64° W, @ 10 links found another large decayed hemlock stump.  
 Found the 2" iron pipe with 3" bronze table and witnesses trees established by D. Lappala. I updated the accessories as noted below to state and county specification.


Act 74 research on file.

**PEER GROUP APPROVED**  
Richard P. Deahn 6/10/97  
 COUNTY REPRESENTATIVE

C. Description of monument for corner and accessories established to perpetuate locating the position of the corner:  
 From the 2" iron pipe with 3" bronze table stamp: T.47-48 N., R.45 W.; 1/4; S-5, S-32; 12585 RLS; 1963. I established the following existing bearing trees and new reference objects:

20" Red Maple	N 18° W	28.20'	
10" Red Maple	N 52° E	26.18'	
20" Sugar Maple	S 37° W	16.12'	
Rail & Sign	N 24° E	4.28'	(face of rail)
6' Rail & Sign	S 06° E	1.32'	(face of rail)

( measurement to nail in side of tree )

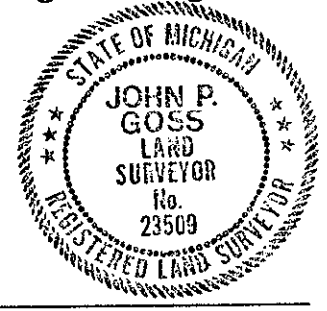

Signed by John P. Goss  
 Surveyor's Michigan License No. 23509

Date May 20, 1997

F<sub>e</sub>d. No. A-7