

**LAND CORNER RECORDATION CERTIFICATE**  
**Filing Requirement of Act 74, Mich. P.A. 1970**

For corners in Gogebic Located in: \_\_\_\_\_ Corner Code # \_\_\_\_\_  
 (County)

1. Public Land Survey T47NR45W D-3  
 T \_\_\_\_\_ R \_\_\_\_\_  
 T \_\_\_\_\_ R \_\_\_\_\_ **SURVEY & MONUMENTATION**  
 T \_\_\_\_\_ R \_\_\_\_\_

2. Property Controlling S \_\_\_\_\_ T \_\_\_\_\_  
 in Section S \_\_\_\_\_ T \_\_\_\_\_ **JAN 05 2001**

3. Miscellaneous S \_\_\_\_\_ T \_\_\_\_\_  
 Property in Sec. S \_\_\_\_\_ T \_\_\_\_\_ **SECTION**

4. Lot No. \_\_\_\_\_, Recorded Plat \_\_\_\_\_  
 5. Private Claims \_\_\_\_\_  
 Quarter Corner common to Sections 5 & 8.

Register's Office }  
 Gogebic County } 88.

Received for record the  
474 day of DEC 2000  
 A. D. 2000 at 10:45 o'clock  
8 m., and recorded in  
 Liber 8 of CORNERS  
 on page 46  
Ramona Collins, Deputy  
 Register of Deeds

Register of Deeds Stamp & File Number

I, John R. Garske, in a field survey on October 31, 2000, do hereby state that under requirements of P.A. 74, Michigan P.A. of 1970, the corner points mentioned in lines 1 and 2 above were in conformance with regulations and rules therefore as required in the current manual of survey instructions of the United States Department of the Interior, Bureau of Land Management or by a decree of a Court of Law and / or that the corner points mentioned in lines 3, 4, and 5 above were in conformance with the rules of the Michigan Board of Land Surveyors or by a Decree of a Court of Law; established, re-established, monumented, recovered, found as expressed below.

NOTE: Not more than 2 corners, all in the same town and range, may be recorded on this certificate.

	A	B	C	D	E	F	G	H	I	J	K	L	M
1													
2	6			5		4		3		2		1	
3				●									
4	7			8		9		10		11		12	
5													
6	18			17		16		15		14		13	
7													
8	19			20		21		22		23		24	
9													
10	30			29		28		27		26		25	
11													
12	31			32		33		34		35		36	
13													

**A. Description of original monument and accessories and / or subsequent restoration:**

Original survey by William Burt in 1848.  
 Original Corner: A Sugar Maple post was set at the Quarter Corner position common to Sections 5 and 8.  
 Original Bearing Trees: 14" Hemlock N 60° W 50 Links  
 12" Hemlock S 65° E 35 Links

**B. Description of corner evidence found and / or method applied in restoring or re-establishing corner:**

No original evidence found.  
 To set the North Quarter Corner of Section 8, I shot the existing fencelines running East-West and North-South. This intersection point falls inline with the Center Quarter Corner of Section 5 and plat monuments found on the South side on Indian Hills Subdivision # 2. See sketch on back.  
 Record research on file.

**DEED GROUP APPROVED**  
Richard P. W. [Signature] 11/29/00  
**COURT REPRESENTATIVE**

**C. Description of monument for corner and accessories established to perpetuate locating the position of the corner:**

I set a standard aluminum Bernsten monument at the quarter corner location common to Sections 5 and 8 and established the following witnesses:

Sign Rail	North	1.98 Feet
8" Maple	N 71° E	30.58 Feet
12" Maple	S 02° E	29.09 Feet
12" Maple	S 68° W	24.86 Feet

Signed by [Signature]

Date \_\_\_\_\_

Surveyor's Michigan License No. 28410  
 FB # 258, page 145

**NORTH ONE QUARTER CORNER  
SECTION 8, T 47 N, R 45 W  
GOGEBIC COUNTY, MICHIGAN**

**SURVEY &  
REMONUMENTATION**

**JAN 05 2001**

**SECTION**

BLANK & WHITE



CENTER 1/4 CORNER  
SECTION 5, T 47 N, R 45 W  
FOUND MONUMENT

S00°25'34"E  
1009.18'



FOUND CONCRETE  
PLAT MONUMENT

NORTH-SOUTH QUARTER LINE, SECTION 5, T 47 N, R 45 W  
S00°25'41"E  
2555.65'

S00°25'50"E

1546.47'

FOUND FENCELINES  
NORTH-SOUTH & EAST-WEST

SET ALUMINUM BERNSTEN  
MONUMENT AT FENCE INTERSECTION



SECTION CORNER  
FOUND ALUMINUM  
BERNSTEN MONUMENT  
T 47 N, R 45 W

S89°21'21"E  
2661.89'  
2656.5' (GLO)




S89°44'29"E 5308.13' 5313.00'(GLO)  
SECTION LINE

N89°52'14"E  
2646.36'  
2656.5' (GLO)



SECTION CORNER  
FOUND ALUMINUM  
BERNSTEN MONUMENT  
T 47 N, R 45 W

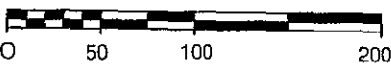

COLEMAN ENGINEERING COMPANY  
ENGINEERING-SURVEYING-GEOTECHNICAL  
205 N. HARRISON STREET  
IRONWOOD, MICHIGAN 49938  
PHONE (906) 932-5048  
FAX (906) 932-3213