

SURVEY & REMONUMENTATION

SEP 08 1998

SECTION

LAND CORNER RECORDATION CERTIFICATE
Filing Requirement of Act 74, Mich. P.A. 1970

Register's Office }
Gogebic County } ss.

For corners in

<u>Gogebic</u> (County)	Located In:	Corner Code #
1. Public Land Survey	Section 17 T <u>47N</u> R <u>45W</u>	<u>D-7</u>
	T <u> </u> R <u> </u>	<u> </u>
	T <u> </u> R <u> </u>	<u> </u>
	T <u> </u> R <u> </u>	<u> </u>
2. Property Controlling in Section	S <u> </u> T <u> </u> R <u> </u>	<u> </u>
	S <u> </u> T <u> </u> R <u> </u>	<u> </u>
3. Miscellaneous Property in Sec.	S <u> </u> T <u> </u> R <u> </u>	<u> </u>
	S <u> </u> T <u> </u> R <u> </u>	<u> </u>

Received for record the
20th day of AUGUST
A. D. 1998 at 1:20 o'clock
P.m., and recorded in
Liber 7 of CORNERS
page 48
Ramona Collins Deputy
Register of Deeds

Register of Deeds Stamp & File Number

4. Lot No. _____, Recorded Plat _____
5. Private Claims _____

1/4 Corner Sections 17 and 20, T47N, R45W

A	B	C	D	E	F	G	H	I	J	K	L	M
1												
2	6		5		4		3		2		1	
3												
4	7		8		9		10		11		12	
5												
6	18		17		16		15		14		13	
7												
8	19		20		21		22		23		24	
9												
10	30		29		28		27		26		25	
11												
12	31		32		33		34		35		36	
13												

I, John R. Garske, in a field survey on August 16, 1998 do hereby state that under requirements of P.A. 74, Michigan P.A. of 1970, the corner points mentioned in lines 1 and 2 above were in conformance with regulations and rules therefore as required in the current manual of survey instructions of the United States Department of the Interior, Bureau of Land Management or by a decree of a Court of Law and/or that the corner points mentioned in lines 3, 4 and 5 above were in conformance with the rules of the Michigan Board of Land Surveyors or by a Decree of a Court of Law; established, re-established, monumented, recovered, found as expressed below:

NOTE: Not more than 2 corners, all in the same town and range, may be recorded on this certificate.

A. Description of original monument and accessories and/or subsequent restoration:

Subdivision lines by William Burt 1848.
Set Iron-wood post quarter Section Corner from which:
- A Lynn 20" in diameter bearing N80 E32 links
- A Lynn 24" in diameter bearing S35 N27 links

B. Description of corner evidence found and/or method applied in restoring or reestablishing corner:

At the 1/4 corner location I found a 3/4 inch diameter iron pipe buried approximately 1 foot below the gravel surface of Sordahl Road, at the intersection with Coldberg Road to the South. The position fits with occupation lines and recorded corners east and west.


(See sketch on back)

(Research on file)

FREE GROUP APPROVAL
Richard L. Wehn 8/19/98
COURT REPRESENTATIVE

C. Description of monument for corner and accessories established to perpetuate locating the position of the corner:

Found 1/2" iron pipe, set 5/8" x 12" Rebar inside iron pipe.
Established the following witnesses:
4" Maple N33°W 41.68 feet
10" Ash N44°E 36.43 feet
Reference Monument S44°W 52.00 feet
Reference Monument S36°E 48.00 feet
(R.M. is a 3 1/4" diam. aluminum cap on a 2 1/2" x 30" diam aluminum rod)

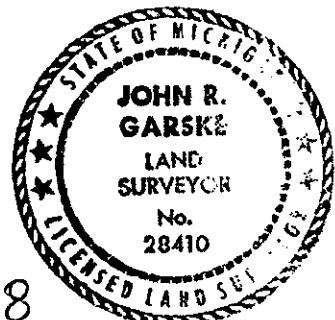

igned by John R. Garske
urveyor's Michigan License No. 28410

Date 8/19/98


Fed. Index N-7

SURVEY &
REMONUMENTATION

SEP 08 1998

SECTION

SKETCH

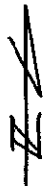
No scale

1/4 COR

17
20

T47N
R45W

FOUND 3/4" IRON PIPE
(D-7)

