

FEB 18 1994

COMMISSION

LAND CORNER RECORDATION CERTIFICATE
Filing Requirement of Act 74, Mich. P.A. 1970

Register's Office }
Gogebic County } ss.

Received for record the
30TH day of DECEMBER
A. D. 1993 at 12:20 o'clock
P m., and recorded in
Liber 4 of CORNERS
on page 317
Betty Joaric Deputy
Register of Deeds

Register of Deeds Stamp & File Number

For corners in

Gogebic
(County)

Located In:

Corner Code #

- 1. Public Land Survey Section 4 T 47N R 45W Corner Code E-2
T _____ R _____
T _____ R _____
T _____ R _____
- 2. Property Controlling S _____ T _____ R _____
in Section S _____ T _____ R _____
- 3. Miscellaneous S _____ T _____ R _____
Property in Sec. S _____ T _____ R _____

- 4. Lot No. _____, Recorded Plat _____
- 5. Private Claims _____

One-quarter corner Section 5 & 4.

December 2 93

I, John R. Garske, in a field survey on _____, 19_____, do hereby certify that under requirements of P.A. 74, Michigan P.A. of 1970, the corner points mentioned in lines 1 and 2 above were in conformance with regulations and rules therefore as required in the current manual of survey instructions of the United States Department of the Interior, Bureau of Land Management or by a decree of a Court of Law and/or that the corner points mentioned in lines 3, 4 and 5 above were in conformance with the rules of the Michigan Board of Land Surveyors or by a Decree of a Court of Law; established, re-established, monumented, re-monumented, recovered, found as expressed below:

NOTE: Not more than 4 corners, all in the same town and range, may be recorded on this certificate.

	A	B	C	D	E	F	G	H	I	J	K	L	M
2	6	5	4	3	2	1							
3													
4	7	8	9	10	11	12							
5													
6	18	17	16	15	14	13							
7													
8	19	20	21	22	23	24							
9													
10	30	29	28	27	26	25							
11													
12	31	32	33	34	35	36							
13													

A. Description of original monument and accessories and/or subsequent restoration:


Original survey by William Burt, U.S.D.S., on December 14, 1848. Set sugar post at 38.74 chs (north to south). Bearing trees:

- 8" fir - N77°E - 32 links
- 9" aspen - S37°W - 35 links

No original evidence found.

B. Description of corner evidence found and/or method applied in restoring or reestablishing corner:

Corner position was marked by an iron pipe for over 40 years but was destroyed by gas line construction. Local long time area resident, Charles Drier, pointed out correct location of corner position to us as he knew it to exist. The corner falls at the intersection of a southerly and westerly ancient fence line on the south side of Drier Road. This position is consistent with natural features and was used and accepted at this location prior to being destroyed.

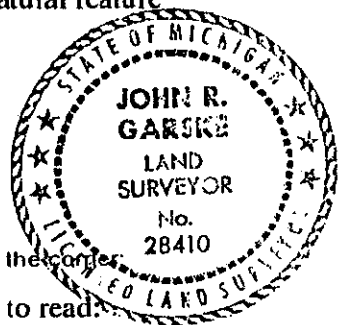

C. Description of monument for corner and accessories established to perpetuate locating the position of the corner:

Set a 3/4" x 30" iron rod with a 3 1/2" aluminum cap 4"± below the surface stamped to read: County Remonumentation; 1/4 cor.; S-4; S-5; T47N, R45W; 1993; RLS 28410, from which I established the following bearing trees or reference objects:

- 11" ash - S04°E - 33.29 feet
- Clump of 3" ash - S80°W - 37.94 feet
- 6" elm - N65°W - 40.58 feet
- Reference monument - 3/4" x 30" long rebar w/stamped aluminum cap - N27°E - 52.26 feet.
- Reference monument - 2 1/2" x 30" aluminum Bernsten monument with a 3 1/2" stamped aluminum cap - S54°E - 34.83 feet - Steel sign post - 1.33 feet

Signed by John R. Garske Date 12/22/93
Surveyor's Michigan License No. 28410