SURVEY &
REMONUMENTATION

AUG 0 8 1997

COMMISSION

LAND CORNER RECORDATION CERTIFICATE
Filing Requirement of Act 74, Mich. P.A. 1970

Register's Office } ss.
Gogebic County }

Received for record the 13TH day of MAY A. D. 1997 at 2:05 o'clock P M., and recorded in Liber 6 of Corners on page 114

Ramona Collins, Deputy
Register of Deeds

Register of Deeds Stamp & File Number

For corners in Gogebic (County)

	Located In:	Corner Code #
1. Public Land Survey	T47NR 45W	E-4
	T___ R___	
	T___ R___	
	T___ R___	
2. Property Controlling in Section	S___ T___ R___	
	S___ T___ R___	
3. Miscellaneous Property in Sec.	S___ T___ R___	
	S___ T___ R___	

4. Lot No. _____, Recorded Plat _____
5. Private Claims _____

1/4 cor. comm. to sec's. 8 & 9

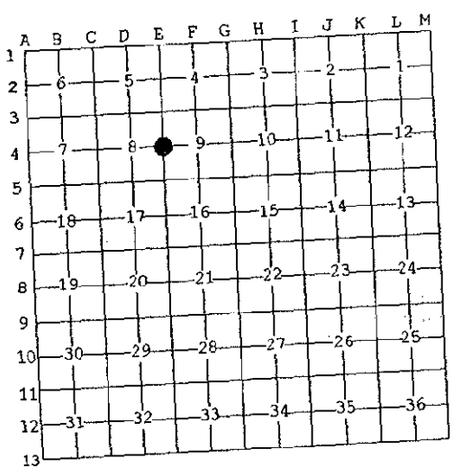

I, John P. Goss, in a field survey on April 21, 1997 do hereby state that under requirements of P.A. 74, Michigan P.A. of 1970, the corner points mentioned in lines 1 and 2 above were in conformance with regulations and rules therefore as required in the current manual of survey instructions of the United States Department of the Interior, Bureau of Land Management or by a decree of a Court of Law and /or that the corner points mentioned in lines 3, 4 and 5 above were in conformance with the rules of the Michigan Board of Land Surveyors or by a Decree of a Court of Law; established, re-established, monumented, recovered, found as expressed below:

NOTE: Not more than 2 corners, all in the same town and range, may be recorded on this certificate.

A. Description of original monument and accessories and/or subsequent restoration:
Original corner established by William Burt in 1848. Set Sugar post.
Original bearing trees: Lynn 18" N 20° E 29 links
Hemlock 18" S 25° W 36 links
John P. Goss, RLS, on Nov. 1, 1984 found iron pipe with 2½" brass cap, marked T.47 N., R.45 W.; 8-9. He recorded said corner in Liber 2, page 715 of Land corners for Gogebic County; He established the following reference objects: 10" Maple, N 18° W, 42.39'; 4" Maple, N 89° E, 27.57'; conc. mon./ rebar, Due East, 51.20; conc. mon./ rebar, Due North, 51.64'

B. Description of corner evidence found and/or method applied in restoring or reestablishing corner:
No original evidence could be found due to road construction.
I found the iron pipe with 2½" brass cap buried 7" inside a monument box and it checked with John P. Goss witnesses. I updated the accessories as noted below to state and county specification.

Act 74 research on file.

C. Description of monument for corner and accessories established to perpetuate locating the position of the corner:
From the iron pipe with 2½" brass cap marked T.47 N., R.45 W, 8-9. I established the following reference objects:

12" Maple	N 18° W	42.39'
6" Maple	N 89° E	27.57'
8" Maple	S 32° W	6.47'
Conc. Mon./ ½" rebar	Due E.	51.20'
Conc. Mon./ ½" rebar	Due W.	51.64'
6' rail & sign	S 04° E	3.7'

PEER GROUP APPROVAL
Richard L. Dean 5/12/97
COUNTY REPRESENTATIVE

STATE OF MICHIGAN
JOHN P. GOSS
LAND SURVEYOR
No. 23509
REGISTERED LAND SURVEYOR

Measurement to trees are to nail in side of tree.

Signed by John P Goss
Date April 22, 1997
Surveyor's Michigan License No. 23509

Fed. No. G-9

FORM APPROVED BY MICHIGAN STATE BOARD OF PROFESSIONAL SURVEYORS, JAN. 28, 1971
REVISED MAY 14, 1975
REVISED JAN., 1983
REVISED OCT., 1995

114