SURVEY &
REMONUMENTATION

FEB 18 1994

COMMISSION

LAND CORNER RECORDATION CERTIFICATE

Filing Requirement of Act 74, Mich. P.A. 1970

Register's Office
Gogebic County } ss.

Received for record the 30TH day of DECEMBER A. D. 19 93 at 12:20 o'clock P m., and recorded in Liber 4 of CORNERS on page 318.

Betty Lasin Deputy
Register of Deeds

Register of Deeds Stamp & File Number

For corners in Gogebic (County)

	Located In:	Corner Code #
1. Public Land Survey	Section 16 T 47N R 45W	E-7
	T ___ R ___	
	T ___ R ___	
	T ___ R ___	
2. Property Controlling	S ___ T ___ R ___	
in Section	S ___ T ___ R ___	
3. Miscellaneous	S ___ T ___ R ___	
Property in Sec.	S ___ T ___ R ___	

4. Lot No. _____, Recorded Plat _____
5. Private Claims _____

Section corner common to Sections 17, 16, 21 & 20.

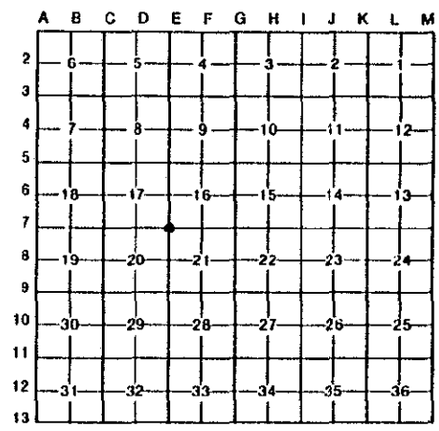

I, John R. Garske, in a field survey on December 2 93, 19 ____, do hereby certify that under requirements of P.A. 74, Michigan P.A. of 1970, the corner points mentioned in lines 1 and 2 above were in conformance with regulations and rules therefore as required in the current manual of survey instructions of the United States Department of the Interior, Bureau of Land Management or by a decree of a Court of Law and/or that the corner points mentioned in lines 3, 4 and 5 above were in conformance with the rules of the Michigan Board of Land Surveyors or by a Decree of a Court of Law; established, re-established, monumented, re-monumented, recovered, found as expressed below:

NOTE: Not more than 4 corners, all in the same town and range, may be recorded on this certificate.

A. Description of original monument and accessories and/or subsequent restoration:

Original survey by William Burt, U.S.D.S., on December 14, 1848. Set cedar post which a 10" cedar bears S10°E, 6 links and a 6" Y. birch bears N45°W, 4 links.

No original evidence found.

B. Description of corner evidence found and/or method applied in restoring or reestablishing corner:

I found a 3/8" square iron rod in concrete in the center line of Pumula and Sordahl Roads. This corner loction and monument is noted in 1940's notes at the City of Wakefield Engineering Department. The monument is generally accepted as marking the true corner position and has been used in many surveys of record.

STATE OF MICHIGAN
JOHN R. GARSKE
LAND SURVEYOR
No. 28410
LICENSED LAND SURVEYOR

C. Description of monument for corner and accessories established to perpetuate locating the position of the corner:

Found 3/8" square iron in conc. Established the following bearing trees and reference objects:

Power pole #68 - N60°E - 34.71 feet
Power pole L.S.D.P. #21-7/93 - S49°E - 34.35 feet
Guy pole #530 - N51°W - 37.15 feet
Reference monument - stamped 3 1/2" aluminum cap on 3/4" x 4' aluminum rod - S45°W - 31.91 feet - Steel sign post - North - 1.61 feet
Reference monument - stamped 3 1/2" aluminum cap on a 4' section of 3/4" aluminum rod - N37°W - 46.16 feet - Steel sign post - 1.65 feet

Signed by John R. Garske Date 12/22/93

Surveyor's Michigan License No. 28410

FORM APPROVED BY MICHIGAN STATE BOARD OF LAND SURVEYORS, JAN. 28, 1971
REVISED MAY 14, 1975
REVISED JAN., 1983