

SURVEY &
REMONUMENTATION

1993

COMMISSION

LAND CORNER RECORDATION CERTIFICATE
Filing Requirement of Act 74, Mich. P.A. 1970

Register's Office }
Gogebic County } ss.

Received for record the
16th day of December
A. D. 1993 at 2:30 o'clock
P m., and recorded in
Liber 4 of CORNERS
on page 313
Betty Saari, Deputy
Register of Deeds

Register of Deeds Stamp & File Number

For corners in Gogebic (County)

Located In: Corner Code #

1. Public Land Survey Section 4	T <u>47N</u> R <u>45W</u>	<u>E-3</u>
	T _____ R _____	_____
	T _____ R _____	_____
	T _____ R _____	_____
2. Property Controlling in Section	S _____ T _____ R _____	_____
	S _____ T _____ R _____	_____
3. Miscellaneous Property in Sec.	S _____ T _____ R _____	_____
	S _____ T _____ R _____	_____

4. Lot No. _____, Recorded Plat _____
5. Private Claims _____

One-quarter corner common to S-4 & S-9, T47N, R45W

December 2 1993

I, John R. Garske, in a field survey on _____, 19_____, do hereby certify that under requirements of P.A. 74, Michigan P.A. of 1970, the corner points mentioned in lines 1 and 2 above were in conformance with regulations and rules therefore as required in the current manual of survey instructions of the United States Department of the Interior, Bureau of Land Management or by a decree of a Court of Law and/or that the corner points mentioned in lines 3, 4 and 5 above were in conformance with the rules of the Michigan Board of Land Surveyors or by a Decree of a Court of Law; established, re-established, monumented, re-monumented, recovered, found as expressed below:

NOTE: Not more than 4 corners, all in the same town and range, may be recorded on this certificate.

	A	B	C	D	E	F	G	H	I	J	K	L	M
2	6	5	4	3	2	1							
3						●							
4	7	8	9	10	11	12							
5													
6	18	17	16	15	14	13							
7													
8	19	20	21	22	23	24							
9													
10	30	29	28	27	26	25							
11													
12	31	32	33	34	35	36							
13													

A. Description of original monument and accessories and/or subsequent restoration:

Survey by William Burt, 1848. Set sugar post from which a 12" lynn bears N50°W, 17 links and a 12" sugar bears S25°E, 20 links. No original evidence found.


B. Description of corner evidence found and/or method applied in restoring or reestablishing corner:

I found a 8" diameter concrete monument with a 1" iron rod at corner position at the intersection of north, south, east and west ancient fence lines. This iron rod was probably set by area mines, circa 1930 by the Brotherton or Castile Mining Company. It has been used and accepted by the County Road Commission, local residents and in various surveys.

C. Description of monument for corner and accessories established to perpetuate locating the position of the corner:

I found a 8" diameter concrete monument with a 1" iron rod. Set a 3 1/2" diameter aluminum cap stamped to identify the corner on the one inch iron rod. Established the following bearing trees and reference objects:

- 3" S. maple - N51°E - 7.71 feet
- 6" ash - S46°W - 19.84 feet
- 7" S. maple - N40°W - 19.50 feet
- Steel sign post - S34°E - 1.85 feet

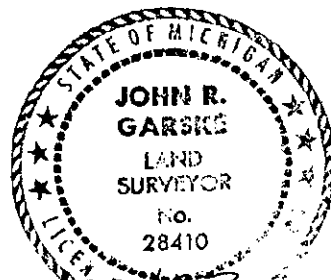

Signed by John R. Garske
Surveyor's Michigan License No. 28410

Date 12/22/93