

**SURVEY &  
REMONUMENTATION**

AUG 6 8 1997

COMMISSION

**LAND CORNER RECORDATION CERTIFICATE  
Filing Requirement of Act 74, Mich. P.A. 1970**

Register's Office }  
Gogebic County } ss.

For corners in

Gogebic  
(County)

Located In:

Corner Code #

1. Public Land Survey

T47NR45W

H- 3

T R

T R

T R

2. Property Controlling  
in Section

S T R

S T R

3. Miscellaneous  
Property in Sec.

S T R

S T R

4. Lot No. \_\_\_\_\_, Recorded Plat \_\_\_\_\_

5. Private Claims \_\_\_\_\_

1/4 cor. comm. to sec's 3 & 10

I, John P. Goss, in a field survey on May 8, 1997 do hereby state that under requirements of P.A. 74, Michigan P.A. of 1970, the corner points mentioned in lines 1 and 2 above were in conformance with regulations and rules therefore as required in the current manual of survey instructions of the United States Department of the Interior, Bureau of Land Management or by a decree of a Court of Law and/or that the corner points mentioned in lines 3, 4 and 5 above were in conformance with the rules of the Michigan Board of Land Surveyors or by a Decree of a Court of Law, established, re-established, monumented, recovered, found as expressed below:

NOTE: Not more than 2 corners, all in the same town and range, may be recorded on this certificate.

A. Description of original monument and accessories and/or subsequent restoration:

Original corner established by William Burt in 1848. Set Sugar post.  
Original bearing trees: Sugar 12" N 55° W 26 links  
Y. Birch 36" S 50° E 16 links

John P. Goss, RLS, on May 6, 1982 found 2 inch I.D. iron pipe. Location of corner fit well with distance on Plans for M-28 and is located at intersection of fence lines. I accepted corner at this location and recorded 2" I.P. in Liber 2 pages 428 & 429 of Land Corners for Gogebic County. I established the following bearing trees: 4" Maple - S 37° E - 35.50'; 5" W. Birch - S 17° W - 30.10'; 7" Maple - N 24° W - 22.15'.

B. Description of corner evidence found and/or method applied in restoring or reestablishing corner:

No original evidence could be found due to logging operation.

This 2" I.P. was lying on the ground. Two (2) of my bearing trees with D.H. nail in them was found. I reestablished the corner position and updated the accessories as noted below to state and county specification.

Act 74 research on file.


C. Description of monument for corner and accessories established to perpetuate locating the position of the corner:

From the two(2) witness trees from my certification I placed a 2 1/2" by 30" aluminum pipe with 3/4" aluminum cap stamped as follows: County Remonumentation; T.47N., R.45 W.; 1/4; S-3, S-10; 1997, P S 23509. I established the following reference objects:

8" White Birch	S 17° W	30.10'
9" Maple	N 24° W	22.15'
10" Basswood	N 38° E	30.36'
6' Rail & sign	S 42° E	1.5'

PEER GROUP APPROVED

Richard L. Dean 5/12/97  
COUNTY REPRESENTATIVE

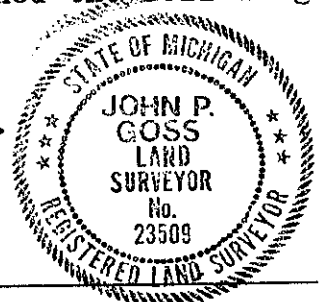

Signed by John P. Goss  
Surveyor's Michigan License No. 23509

Date May 8, 1997

Fed. No. E - 15

A	B	C	D	E	F	G	H	I	J	K	L	M
1												
2	6		5		4		3		2		1	
3							●					
4	7		8		9		10		11		12	
5												
6	18		17		16		15		14		13	
7												
8	19		20		21		22		23		24	
9												
10	30		29		28		27		26		25	
11												
12	31		32		33		34		35		36	
13												

Register of Deeds Stamp & File Number

Received for record the  
13<sup>th</sup> day of MAY  
A. D. 1997 at 2:05 o'clock  
P m., and recorded in  
Liber 6 of CORNERS  
on page 119  
Ramona Collins, Deputy  
Register of Deeds