

**LAND CORNER RECORDATION CERTIFICATE**  
**Filing Requirement of Act 74, Mich. P.A. 1970**

For corners in

<u>Gogebic</u> (County)	Located In:	Corner Code #
1. Public Land Survey Section 15	T47N R.45W	I-5
	T ___ R	
	T ___ R	
	T ___ R	
2. Property Controlling in Section	S ___ T ___ R	
	S ___ T ___ R	
3. Miscellaneous Property in Sec.	S ___ T ___ R	
	S ___ T ___ R	


**SURVEY &  
 MONUMENTATION**

**JAN 05 2001**

Register's Office } ss.  
 Gogebic County }

Received for record the  
2<sup>nd</sup> day of JUNE  
 A. D. 2000 at 10:20 o'clock  
10 m., and recorded in  
 Liber 7 of CORNERS  
 on page 361  
*Cheryl Rypke, Esq.*  
 Register of Deeds  
 Register of Deeds Stamp & File  
 Number

4. Lot No. \_\_\_\_\_, Recorded Plat \_\_\_\_\_ **SECTION**  
 5. Private Claims \_\_\_\_\_  
 Section Corner common to Sections 10, 11, 14, & 15.

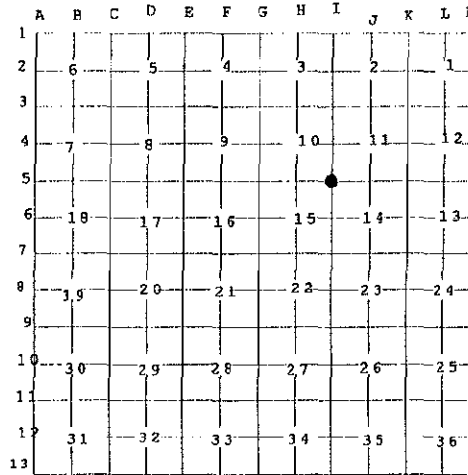

I, John R. Garske, in a field survey on March 29, 2000 do hereby state that under requirements of P.A. 74, Michigan P.A. of 1970, the corner points mentioned in lines 1 and 2 above were in conformance with regulations and rules therefore as required in the current manual of survey instructions of the United States Department of the Interior, Bureau of Land Management or by a decree of a Court of Law and/or that the corner points mentioned in lines 3, 4 and 5 above were in conformance with the rules of the Michigan Board of Land Surveyors or by a Decree of a Court of Law; established, re-established, monumented, recovered, found as expressed below:

**NOTE: Not more than 2 corners, all in the same town and range, may be recorded on this certificate.**

**A. Description of original monument and accessories and/or subsequent restoration:**

Corner established by William Burt in 1848.  
 Set Sugar Maple post at the Section Corner of Sections 10, 11, 14, and 15.  
 Original Bearing Trees: 14" Hemlock N 35° E 34 Links  
 10" Sugar Maple S 35°W 9 Links

**B. Description of corner evidence found and/or method applied in restoring or reestablishing corner:**

I found a 6 1/2" x 6 1/2" concrete monument with a 1/2" diameter iron pin lying on the extension of a rock wall line and an ancient fence line intersection.  
 I accepted the monument as marking the section corner. It is typical of the monuments set by mining era surveyors and is in harmony with local occupation lines.

Record Research on File.

**NEED GROUP APPROVED**  
*Richard L. Duden* 5/24/00  
 COUNTY REGISTER

**C. Description of monument for corner and accessories established to perpetuate locating the position of the corner:**

I accepted the above described 1/2" iron pin as the NE corner of Section 15. From this corner I established the following witnesses:

7" Maple	N 50° W	7.82 Feet
3" Ironwood	N 30° E	5.07 Feet
4" Maple	S 12° E	7.70 Feet
7" Maple	S 35° W	11.16 Feet
Steel Sign Post	East	2.8 Feet

Signed by *John R. Garske*  
 Surveyor's Michigan License No. 28410  
 FB # 242, PG # 114

