

LAND CORNER RECORDATION CERTIFICATE
Filing Requirement of Act 74, Mich. P.A. 1970

Register's Office }
 Gogebic County } ss.

For corners in

Gogebic Located In: Corner Code #
 (County)

1. Public Land Survey T47N R 45W I-6
 T R
 T R
 T R
 T R
 T R

2. Property Controlling S T R
 in Section S T R


3. Miscellaneous S T R
 Property in Sec. S T R

SURVEY & MONUMENTATION
JAN 05 2001
SECTION

Received for record the
2ND day of JUNE
 A. D. 2000 at 10:20 o'clock
A m., and recorded in
 Liber 7 of CORNERS
 on page 362
Cheryl Ruppel, Reg.
 Register of Deeds
 Register of Deeds Stamp & File
 Number

4. Lot No. _____, Recorded Plat _____
 5. Private Claims _____
 Quarter Corner common to Sections 14 and 15.

I, John R. Garske, in a field survey on March 29, 2000 do hereby state that under requirements of P.A. 74, Michigan P.A. of 1970, the corner points mentioned in lines 1 and 2 above were in conformance with regulations and rules therefore as required in the current manual of survey instructions of the United States Department of the Interior, Bureau of Land Management or by a decree of a Court of Law and /or that the corner points mentioned in lines 3, 4 and 5 above were in conformance with the rules of the Michigan Board of Land Surveyors or by a Decree of a Court of Law; established, re-established, monumented, recovered, found as expressed below:

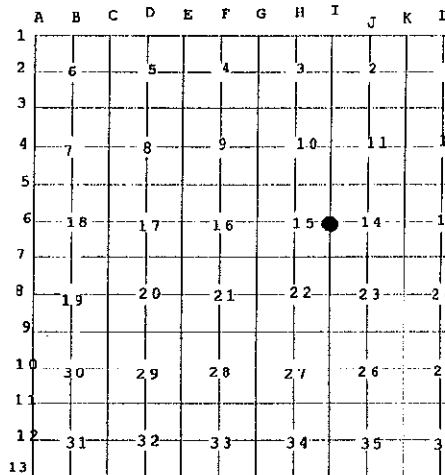

NOTE: Not more than 2 corners, all in the same town and range, may be recorded on this certificate.

A. Description of original monument and accessories and/or subsequent restoration:

Corner established by William Burt, in 1848.
 Original Bearing Trees: 14" Basswood N 05° E 24 Links
 10" Basswood N 65° W 17 Links
 Original corner: Sugar Maple post.

B. Description of corner evidence found and/or method applied in restoring or reestablishing corner:

I found no evidence of existing quarter corner except an M.D.O.T. bearing tree marked with an M.D.O.T. washer. There were other trees that matched with listed M.D.O.T. bearing trees that didn't have the identifying M.D.O.T. washer. These were as follows

6" Maple	S 22° E	6.30 Feet
8" Maple	S 70° E	13.97 Feet


There was also an ancient fenceline running North and South, through the approximate quarter corner location, with a treeline to the West.
 1969 MDOT plans show this corner to be in, with ties to the centerline of US-2. The fence line intersection checks well with the MDOT plans.
 Record Research on File.

BEEN GROUP APPROVED
Richard P. Decker 5/24/00
 COUNTY SUPERVISOR

C. Description of monument for corner and accessories established to perpetuate locating the position of the corner:

I set a 30" aluminum Bernsten monument from the marked M.D.O.T. bearing tree using listed bearing and distance from the ancient fenceline and from the treeline, from which I established the following witnesses:

14" Sugar Maple	N 69° W	40.95 Feet
12" Sugar Maple	S 72° E	14.11 Feet
12" Yellow Birch	N 50° E	60.90 Feet
10" Basswood	S 08° W	17.01 Feet
4' Steel Sign Post	S 10° E	2.32 Feet

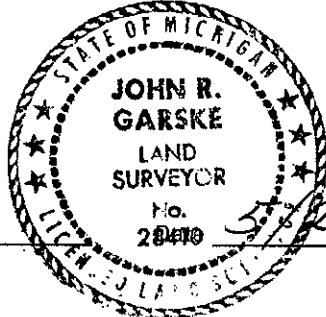

Signed by John R. Garske
 Surveyor's Michigan License No. 28410