

SURVEY &
REMONUMENTATION


COMP 3/3/95 - 15
COMP 5/10/95 - 15

LAND CORNER MONUMENTS

JAN 20 1999

T. 47 N., R. 45 W.

SECTION

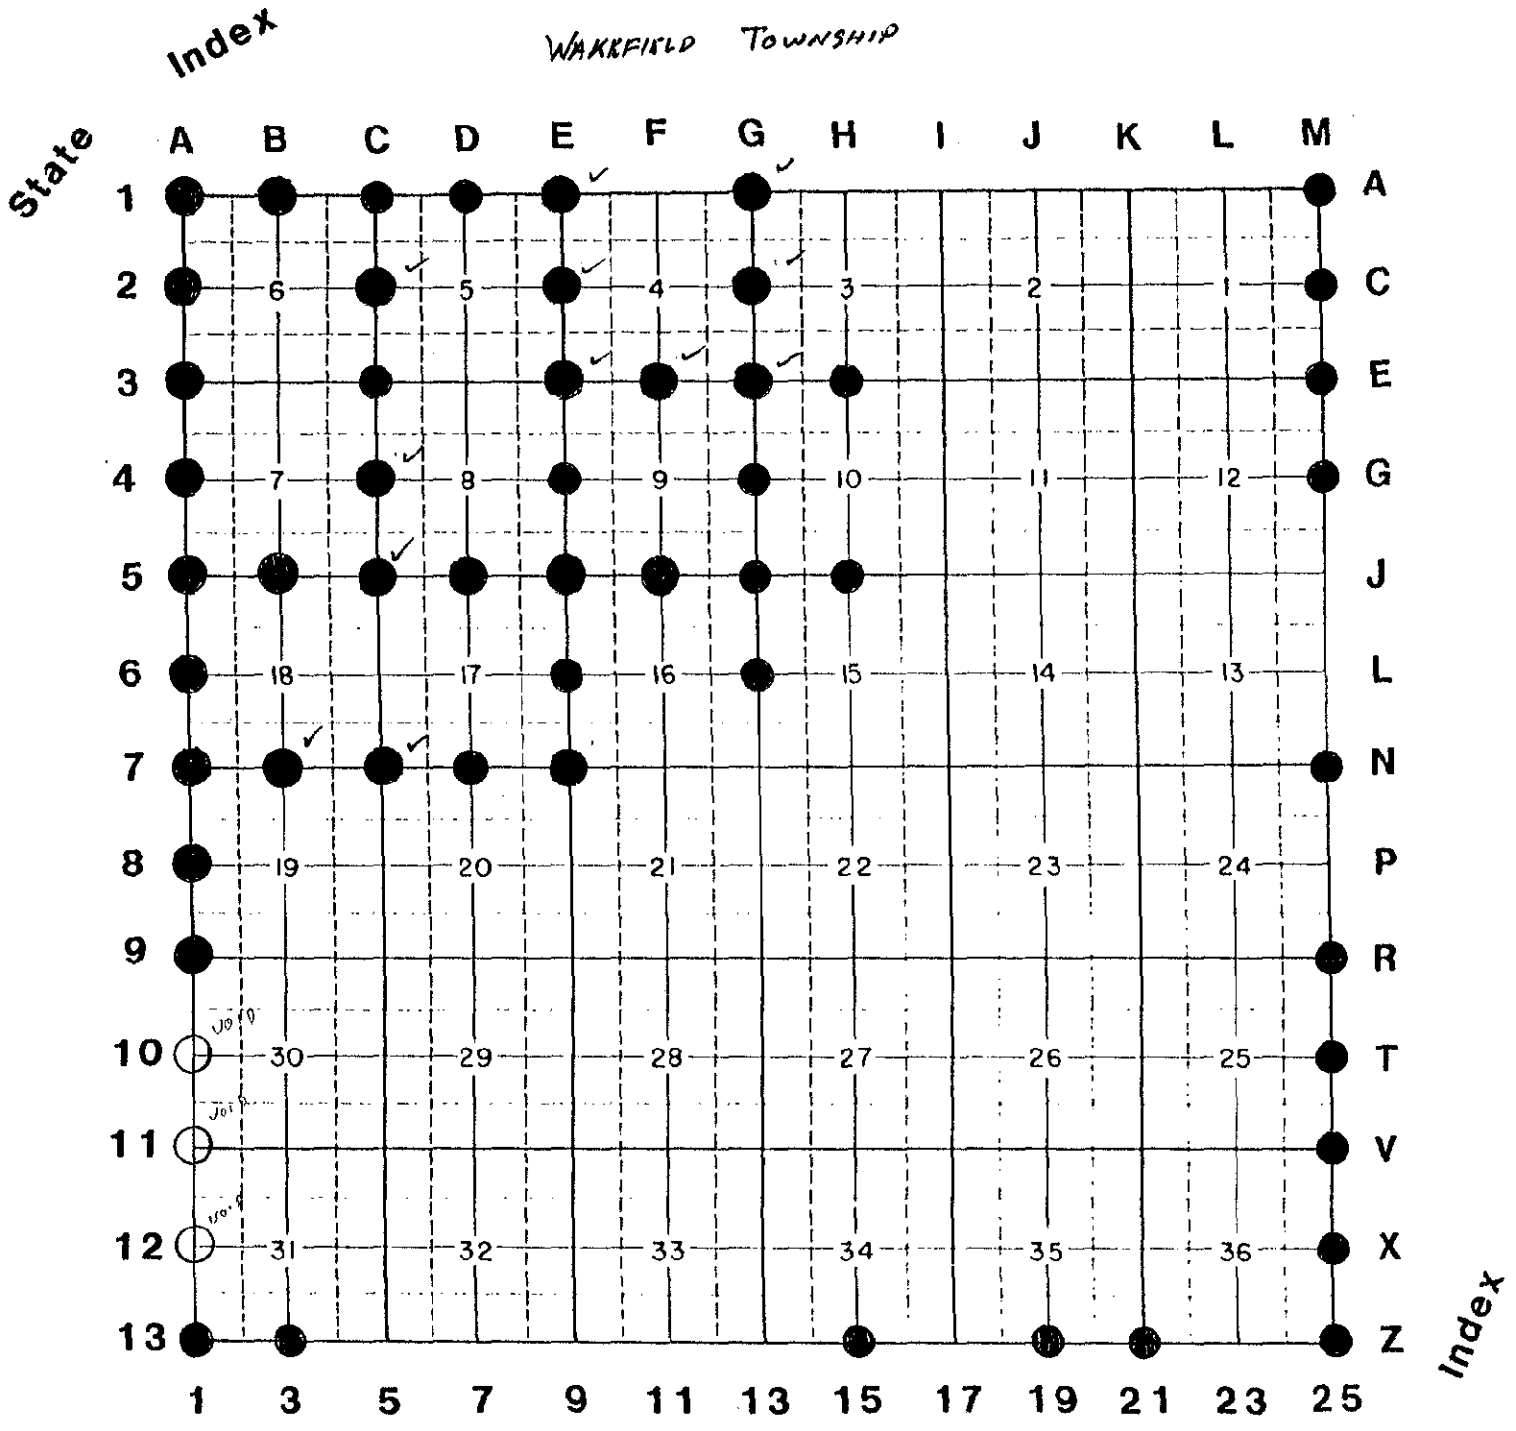

AS OF 12/31/98

LEGEND

Federal

- GLO Corners researched
- ⊙ GLO Corners monumented, not approved
- ⊗ GLO Corners approved
- GLO Corners approved & reported to State

T. 47 N., R. 45 W.