

LAND CORNER RECORDATION CERTIFICATE
Filing Requirement of Act 74, Mich. P.A. 1970

Register's Office }
 Gogebic County } ss.

Received for record the
19TH day of AUGUST
 A. D. 1994 at 1:15 o'clock
P m., and recorded in
 Liber 5 of CORNERS
 on page 76,
Romona Collins Deputy
 Register of Deeds

For corners in
Gogebic
 (County)

Located In: Corner Code #/7

1. Public Land Survey <u>S-1</u>	T <u>47N</u> R <u>47W</u> M-3	
	T _____ R _____	
	T <u>47N</u> R <u>46W</u> A-3	
	T _____ R _____	
2. Property Controlling in Section	S _____ T _____ R _____	
	S _____ T _____ R _____	
3. Miscellaneous Property in Sec.	S _____ T _____ R _____	
	S _____ T _____ R _____	

Register of Deeds Stamp & File Number

4. Lot No. _____, Recorded Plat _____
 5. Private Claims _____

	A	B	C	D	E	F	G	H	I	J	K	L	M
2	6	5	4	3	2	1							
3													
4	7	8	9	10	11	12							
5													
6	10	17	16	15	14	13							
7													
8	19	20	21	22	23	24							
9													
10	30	29	28	27	26	25							
11													
12	31	32	33	34	35	36							
13													

I, John R. Garske, in a field survey on May 17, 1994, do hereby certify that under requirements of P.A. 74, Michigan P.A. of 1970, the corner points mentioned in lines 1 and 2 above were in conformance with regulations and rules therefore as required in the current manual of survey instructions of the United States Department of the Interior, Bureau of Land Management or by a decree of a Court of Law and/or that the corner points mentioned in lines 3, 4 and 5 above were in conformance with the rules of the Michigan Board of Land Surveyors or by a Decree of a Court of Law; established, re-established, monumented, re-monumented, recovered, found as expressed below:

NOTE: Not more than 4 corners, all in the same town and range, may be recorded on this certificate.

A. Description of original monument and accessories and/or subsequent restoration:

Original survey by William A. Burt on September 8, 1847. Set sugar post. Original Bearing
 Trees: 8" cedar - S28°E - 4 links; 12" cedar - S60°W - 20 links

1988 survey by John R Garske, RLS 28410. Set railroad spike at corner position and recorded in Liber 3 of Land Corners, page 252. Accessories: 8" twin ash - N30°W - 63.40 feet; 4" elm - S44°W - 65.25 feet; P. Pole - S28°E - 35.97 feet.

B. Description of corner evidence found and/or method applied in restoring or reestablishing corner:

I found a railroad spike at corner position which checks with Garske's witnesses in his certificate. I updated the corner monument and accessories as noted below to state and county specifications.

Act 74 research on file with County Register of Deeds Office.

PEER GROUP


Approved

Richard P. Walsh 6/17/94

C. Description of monument for corner and accessories established to perpetuate locating the position of the corner:

I replaced the railroad spike with a 3/4" x 30" rebar and a 3 1/4" aluminum cap stamped: S-1, S-6, S-12, S-7, T47N, R47W, R46W, 1994, RLS 28410. I established the following bearing trees and reference objects: Reference monument consisting of a 2 1/2" x 30" aluminum pipe with 3 1/4" aluminum cap stamped to indicate corner position - Due North - 27.00 feet with steel sign post 1.85 feet away.

Power pole - S28°E - 35.97 feet
 4" ash - S45°W - 71.61 feet
 8" twin ash - N30°W - 63.40 feet

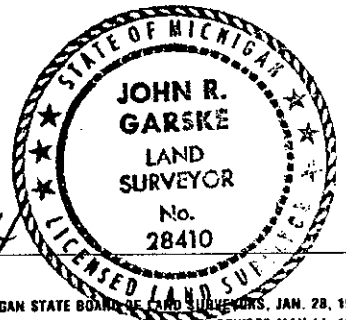

Signed by John R Garske Date 6/10/94
 Surveyor's Michigan License No. 28410