

**LAND CORNER RECORDATION CERTIFICATE**  
**Filing Requirement of Act 74, Mich. P.A. 1970**

Register's Office }  
 Gogebic County } ss.

Received for record the  
19<sup>th</sup> day of August  
 A. D. 1994 at 1.15 o'clock  
P m., and recorded in  
 Liber 5 of CORNERS  
 on page 79.

*Ramona Collins, Deputy*  
 Register of Deeds

Register of Deeds Stamp & File Number

For corners in  
Gogebic  
 (County)

Located In: Corner Code #

1. Public Land Survey S-12	T 47N R 47W	M-4
	T R	
	T 47N R 46W	A-4
	T R	
2. Property Controlling in Section	S T R	
	S T R	
3. Miscellaneous Property in Sec.	S T R	
	S T R	

4. Lot No. \_\_\_\_\_, Recorded Plat \_\_\_\_\_  
 5. Private Claims \_\_\_\_\_

I, John R. Garske, in a field survey on May 5, 1994, do hereby certify that under requirements of P.A. 74, Michigan P.A. of 1970, the corner points mentioned in lines 1 and 2 above were in conformance with regulations and rules therefore as required in the current manual of survey instructions of the United States Department of the Interior, Bureau of Land Management or by a decree of a Court of Law and/or that the corner points mentioned in lines 3, 4 and 5 above were in conformance with the rules of the Michigan Board of Land Surveyors or by a Decree of a Court of Law; established, re-established, monumented, re-monumented, recovered, found as expressed below:

**NOTE: Not more than 4 corners, all in the same town and range, may be recorded on this certificate.**


A	B	C	D	E	F	G	H	I	J	K	L	M
2	6	5	4	3	2	1						
3												
4	7	8	9	10	11	12						
5												
6	18	17	16	15	14	13						
7												
8	19	20	21	22	23	24						
9												
10	30	29	28	27	26	25						
11												
12	31	32	33	34	35	36						

A. Description of original monument and accessories and/or subsequent restoration:  
**Original survey by Austin Burt, June 1851, set cedar post. Original Bearing Trees:**  
 Cedar 8" - S28°E - 4 links, Cedar 12" - S60°W - 20 links  
 Survey by U.S.D.A. in 1938. Set 5" square concrete monument with a stamped 2" bronze cap noting corner position.  
 Survey by John R. Garske, RLS 28410, in October of 1987. Found U.S.D.A. monument and is recorded in Liber 3 of Land Corners, page 261.

B. Description of corner evidence found and/or method applied in restoring or reestablishing corner:  
 I found the U.S.D.A. monument and accessories as noted above and updated the accessories as noted below to bring them up to state and county specifications.  
 Act 74 research on file with County Register of Deeds Office.

**PEER GROUP** Approved  
*Richard L. Pruhn* 6/17/94

C. Description of monument for corner and accessories established to perpetuate locating the position of the corner:  
 2" bronze cap in 5" square concrete monument, cap stamped: USDA - 1/4, T47N, R47W, R46W, S-12, S-7, 1938, from which I established the following bearing trees and reference objects:  
 Steel sign post - Due North - 0.94 feet  
 6" maple - S72°W - 10.82 feet  
 Existing 10" maple - N49°E - 17.18 feet  
 Existing 6" maple - S49°E - 17.87 feet

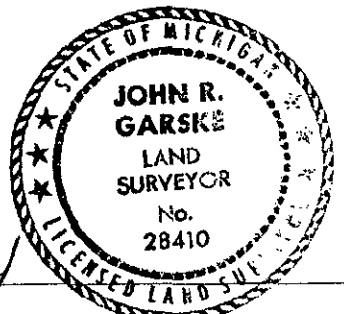

Signed by John R. Garske Date 6/10/94  
 Surveyor's Michigan License No. 28410