

LAND CORNER RECORDATION CERTIFICATE
Filing Requirement of Act 74, Mich. P.A. 1970

Register's Office }
 Gogebic County } ss.

Received for record the
19th day of August
 A. D. 1994 at 1:20 o'clock
P m., and recorded in
 Liber 5 of CORNERS
 on page 87
Ramona Collins, Deputy
 Register of Deeds

Register of Deeds Stamp & File Number

For corners in
Gogebic
 (County)

Located In: Corner Code #

1. Public Land Survey <u>S-13</u>	T <u>47N</u> R <u>47W</u> M-6 <u>47N</u> R <u>46W</u> A-6 T _____ R _____ T _____ R _____
2. Property Controlling in Section	S _____ T _____ R _____ S _____ T _____ R _____
3. Miscellaneous Property in Sec.	S _____ T _____ R _____ S _____ T _____ R _____

4. Lot No. _____, Recorded Plat _____
 5. Private Claims _____

I, John R. Garske, in a field survey on May 5, 1994, do hereby certify that under requirements of P.A. 74, Michigan P.A. of 1970, the corner points mentioned in lines 1 and 2 above were in conformance with regulations and rules therefore as required in the current manual of survey instructions of the United States Department of the Interior, Bureau of Land Management or by a decree of a Court of Law and/or that the corner points mentioned in lines 3, 4 and 5 above were in conformance with the rules of the Michigan Board of Land Surveyors or by a Decree of a Court of Law; established, re-established, monumented, re-monumented, recovered, found as expressed below:

A	B	C	D	E	F	G	H	I	J	K	L	M
2	6	5	4	3	2	1						
3												
4	7	8	9	10	11	12						
5												
6	18	17	16	15	14	13						
7												
8	19	20	21	22	23	24						
9												
10	30	29	28	27	26	25						
11												
12	31	32	33	34	35	36						
13												

NOTE: Not more than 4 corners, all in the same town and range, may be recorded on this certificate.

A. Description of original monument and accessories and/or subsequent restoration:

Original survey by John Burt, D.S., in 1848, set spruce post. Original Bearing Trees:
 Hemlock 8" - N29°E - 4 links
 Spruce 10" - S45°W - 5 links

Survey by John R. Garske, RLS 28410, on June 6, 1990. Set 2" x 24" iron pipe with a stamped 2" brass cap and recorded in Liber 3 of Land Corners, page 373 (accessories noted below).

B. Description of corner evidence found and/or method applied in restoring or reestablishing corner:

I found the 2" iron pipe with a 2" brass cap set in 1990 and updated accessories as noted below to bring them up to state and county specifications. All accessories noted in 1990 L.C.R.C. are in good condition and noted below.

Act 74 research on file with County Register of Deeds Office.

PEER GROUP


Approved

Richard L. Dealm 8/17/94

C. Description of monument for corner and accessories established to perpetuate locating the position of the corner:

2" diameter iron pipe with 2" brass cap stamped: 1/4 cor., 13/18, T47N, R46W, 7/90, RLS 28410. Established the following bearing trees and reference objects:

- Steel sign post - Due North - 1.15 feet
- 8" twin sugar - S42°W - 6.97 feet
- 10" twin sugar - N39°E - 10.11 feet
- 4" oak - S71°E - 8.07 feet

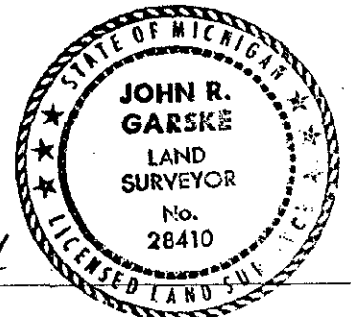

Signed by John R. Garske
 Surveyor's Michigan License No. 28410

Date 6/9/94