Register's Office

			Gogebic tounty 3n.
		R RECORDATION CERTI	
For corners in	rning Require	ment of Act 74, Mich. P.	A. D. 19 94 at 4:00 o'clock
Gogebic	Located In:	Corner Code ##	P m., and recorded in
(County)			When B of CORNERS
1. Public Land Survey	T 47N R 47W	M-7	99 page 12-4
	T 47N. R 46W.	A-7	Ramona Collins, Deputy Register of Blocks
O. Branchy Controlling	STR		uekrote: or poor
2. Property Controlling in Section	S T R		
3. Miscellaneous	S T R		Register of Deeds Stamp & File Number
Property in Sec.	S T R		
	Recorded Plat		ABCDEFGHIJKLM
5. Private Claims		0.4 (D.433) D.43337	
Section corner common to Sections 13 & 24, T47N, R47W and Sections 18 & 19, T47N, R46W.			3
and Sections	s 16 & 19, 14/N, K40W.		4 7 8 9 10 11 12
John R. Garske	, in a field survey on	June_23, 1994	
do hereby certify that under requirements of P.A. 74, Michigan P.A. of 1970, the corner points mentioned in lines 1 and 2 above were in conformance with regulations and rules therefore as required in the current manual of survey instructions of the United States Department of the Interior, Bureau of Land Management or by a decree of a Court of Law and/or that the corner points mentioned in lines 3, 4 and 5			oned 6 10 17 15 15 14 13
			Land '
			and 5 8 19 20 21 22 23 24
above were in conformance with the rules of the Michigan Board of Land Surveyors or by a Decree of a Court of Law; established, re-established, monumented, re-monumented, recovered, found as			id as
expressed below:			10 30 29 28 27 26 25
NOTE: Not more than 4 corners, all in the same town and range, may be recorded			11
on this certificate.	•		12 31 32 33 34 35 36
A. Description of original	monument and accessories and	/or subsequent restoration	13[
- On Septem a spruce 12"	nber 6, 1847, William A. Bu ' bears S17°E, 45 links and a	rt set maple post corner a spruce 12" bears S30°	of Sections 13 and 24 from which W, 52 links.
-			earing trees. Fir 6" - N73°W 19

- links; spruce 8" N78°E, 8 links. No original evidence could be found due to road construction.
- On May 21, 1986 and August 1, 1991, J. Goss, RLS 23509 restored corner from ties by M.D.O.T. Highway plans for US-2. Set 1 1/4" iron pin as recorded on Liber 2, P. 779 and Liber 4, P. 4. Accessories: P. pole S78°W, 51.13 feet; P. pole N88°E, 89.35 feet; P. pole S11°E Description pf300 reetevidence found and/or method applied in restoring or reestablishing corner:

I found a P.K. nail at corner position which checked with Goss recordation certificates as described above and updated the corner as noted below to bring it up to county and state specifications.

Act 74 research on file with County Register of Deeds Office.

PEER GROUP

Approved

C. Description of monument for corner and accessories established to perpetuate locating the position of the corner:

Using the found P.K. nail at the corner location, I established the following reference objects: Two reference monuments consisting of a 2 1/2" x 30" aluminum pipe with a 3 1/4" aluminum cap stamped to indicae the corner position as follows: RM#1 - S33°W, 55.24 feet with a steel sign post 1.57 feet away; RM#2 - S41°E, 56.53 feet with a steel sign post 1.62 feet away; P. pole #18 - 07/06 - N88°E, 89.35 feet; P. pole #19 - 8/92 - S11°E, 111.30 feet.

SEE SKETCH ON BACK JOHN R.

Surveyor's Midbigan License No. .


AND

FED No. N-25

SKETCH

NO SCALE

NOTE: BEARINGS AREMAGNETIC

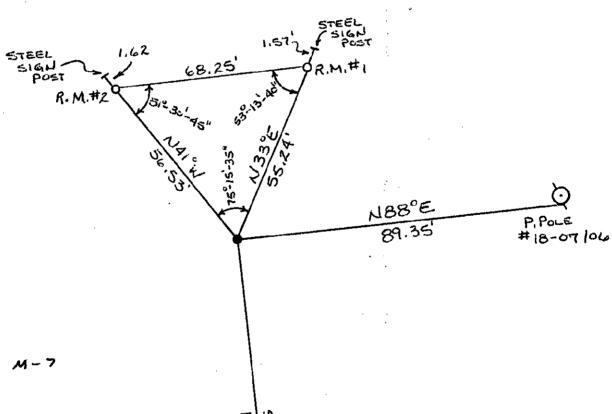

47-47, M-7

11.30. 11.0E

DP. POLE #19-8192