

LAND CORNER RECORDATION CERTIFICATE
Filing Requirement of Act 74, Mich. P.A. 1970

For corners in

_____	Gogebic (County)	Located In:	Corner Code #
1. Public Land Survey	S-36	T 47N R 47W	M-12
		T _____ R _____	
		T _____ R _____	
		T _____ R _____	
2. Property Controlling in Section	S _____	T 47N R 46W	A-12
	S _____	T _____ R _____	
3. Miscellaneous Property in Sec.	S _____	T _____ R _____	
	S _____	T _____ R _____	

Register's Office }
 Gogebic County } ss.

Received for record this
12TH day of APRIL
 A. D. 1995 at 11:15 o'clock
9 m., and recorded in
 Liber 5 of CORNERS
 on page 237.
Ramona Collins, Deputy
 Register of Deeds

Register of Deeds Stamp & File Number

4. Lot No. _____, Recorded Plat _____
 5. Private Claims _____

One-quarter corner common to Section 36, T47N, R47W
 and Section 31, T47N, R46W

I, John R. Garske, in a field survey on March 23, 1995, do hereby certify that under requirements of P.A. 74, Michigan P.A. of 1970, the corner points mentioned in lines 1 and 2 above were in conformance with regulations and rules therefore as required in the current manual of survey instructions of the United States Department of the Interior, Bureau of Land Management or by a decree of a Court of Law and/or that the corner points mentioned in lines 3, 4 and 5 above were in conformance with the rules of the Michigan Board of Land Surveyors or by a Decree of a Court of Law; established, re-established, monumented, re-monumented, recovered, found as expressed below:

	A	B	C	D	E	F	G	H	I	J	K	L	M
2	6	5	4	3	2	1							
3													
4	7	8	9	10	11	12							
5													
6	18	17	16	15	14	13							
7													
8	19	20	21	22	23	24							
9													
10	30	29	28	27	26	25							
11													
12	31	32	33	34	35	36							
13													

NOTE: Not more than 4 corners, all in the same town and range, may be recorded on this certificate.

A. Description of original monument and accessories and/or subsequent restoration:

On September 6, 1847, William Austin Burt set a spruce post from which a 8" tamarack bears N80°E, 22 links and a 8" spruce - N67°W, 17 links.

B. Description of corner evidence found and/or method applied in restoring or reestablishing corner:

I established the corner position by single proportion measurement along the range line. The corner is positioned midway and on line between the section corner common to Sections 25, 36, 30 and 31 and Sections 1, 36, 31 and 6. No other evidence of the corner position could be found. It falls one foot east of the centerline of South Davis Road at the centerline of a trail running east.

Act 74 record research on file with Register of Deeds.


PEER GROUP APPROVED

Richard L. Deahn 4/6/95
 COUNTY REPRESENTATIVE

C. Description of monument for corner and accessories established to perpetuate locating the position of the corner:

I set a 2 1/4" diameter brass cap stamped: T47N, R47W, R46W; S-36; S-31; 1995; RLS 28410, from which I established the following bearing trees and/or reference objects: power pole - N48°E, 41.33 feet; 8" tamarack - S64°W, 68.24 feet; guy pole - N49°W, 46.22 feet; a reference monument consisting of a 2 1/2 diameter x 30" long aluminum pipe with a 3 1/4" diameter aluminum cap stamped: County Remonumentation; T47N, R47W, R46W; 1/4; R.M.; S-36; S-31; 1995; RLS 28410; N49°W, 55.33 feet; a 6 foot steel rail with sign - 1.45 feet away.

Signed by John R. Garske Date 4/6/95
 Surveyor's Michigan License No. 28410

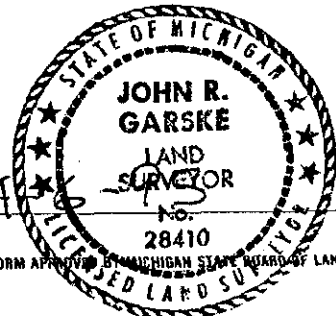

FORM APPROVED BY MICHIGAN STATE BOARD OF LAND SURVEYORS, JAN. 28, 1971
 REVISED MAY 14, 1975
 REVISED JAN., 1983