

LAND CORNER RECORDATION CERTIFICATE
Filing Requirement of Act 74, Mich. P.A. 1970

Register's Office }
 Gogebic County } ss.

For corners in
Gogebic
 (County)

Located In: Corner Code #

1. Public Land Survey	Sec. 7	T 47N R 46W	B-5
		T _____ R _____	_____
		T _____ R _____	_____
		T _____ R _____	_____
2. Property Controlling in Section	S _____	T _____ R _____	_____
	S _____	T _____ R _____	_____
3. Miscellaneous Property in Sec.	S _____	T _____ R _____	_____
	S _____	T _____ R _____	_____

Received for record the
14TH day of AUGUST

A. D. 1995 at 10:10 o'clock

A M., and recorded in

Liber 5 of CORNERS

on page 289

Ramona Collins Deputy
 Register of Deeds

Register of Deeds Stamp & File Number

4. Lot No. _____, Recorded Plat _____
 5. Private Claims _____

1/4 cor. comm. to sec's. 7 & 18

I, John P. GOSS, in a field survey on July 27, 1995, do hereby certify that under requirements of P.A. 74, Michigan P.A. of 1970, the corner points mentioned in lines 1 and 2 above were in conformance with regulations and rules therefore as required in the current manual of survey instructions of the United States Department of the Interior, Bureau of Land Management or by a decree of a Court of Law and/or that the corner points mentioned in lines 3, 4 and 5 above were in conformance with the rules of the Michigan Board of Land Surveyors or by a Decree of a Court of Law, established, re-established, monumented, re-monumented, recovered, found as expressed below:

NOTE: Not more than 4 corners, all in the same town and range, may be recorded on this certificate.

A	B	C	D	E	F	G	H	I	J	K	L	M
2	6	5	4	3	2	1						
3												
4	7	8	9	10	11	12						
5												
6	18	17	16	15	14	13						
7												
8	19	20	21	22	23	24						
9												
10	30	29	28	27	26	25						
11												
12	31	32	33	34	35	36						
13												

A. Description of original monument and accessories and/or subsequent restoration:

Original corner established by Austin Burt in June 1851. Set post.
 Original bearing trees: Fir 8" N 24° E 71 links
 Fir 8" S 04° W 48 links

John R. Garske and John P. Goss found iron rod in monument box in State Highway U.S. #2 and recorded it in Liber 3 on Page 263 of Land Corners for Gogebic County in 1988. They established the following witnesses and distances. P.Pole #7-42/09-N72°W-140.78'; P.Pole #7-46/09-N29°E-82.07'; P.Pole #7-47/90-S38°E-164.66'.

B. Description of corner evidence found and/or method applied in restoring or reestablishing corner:

I found the iron^{rod} in monument box in State Highway U.S. #2 marking the corner position and it checked with witnesses in John R. Garske and John P. Goss certification. I updated the corner monument and accessories as noted below to state and county specification.

Act 74 reseach on file with the County Register of Deeds Office.


PEER GROUP
Richard P. Drahn 8/8/95
 COUNTY

C. Description of monument for corner and accessories established to perpetuate locating the position of the corner:

A iron rod in monument box marks the corner position from which I established the following bearing objects.

I set reference monuments consisting of 2½" by 30" aluminum pipe with a ¾" aluminum cap stamped to indicated the corner position.

R.M.	N 28° W	48.92'
R.M.	S 30° W	109.16'
P.Pole #7-42/09	N 72° W	140.78'
P.Pole #7-46/09	N 29° E	82.07'

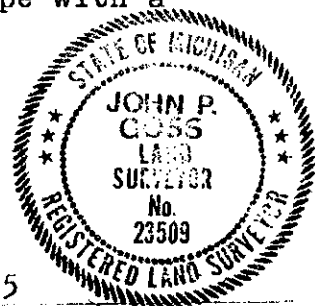

Signed by John P Goss

Date July 30, 1995

Surveyor's Michigan License No. P.S. 23509