

**LAND CORNER RECORDATION CERTIFICATE**  
**Filing Requirement of Act 74, Mich. P.A. 1970**

For corners in

<u>Gogebic</u> (County)	Located In: R.R.D. <u>47</u>	Corner Code # <u>B-7</u>
1. Public Land Survey Sec. 18	T <u>48N</u> R <u>46W</u>	<u>B-7</u>
	T _____ R _____	_____
	T _____ R _____	_____
	T _____ R _____	_____
2. Property Controlling in Section	S _____ T _____ R _____	_____
	S _____ T _____ R _____	_____
3. Miscellaneous Property in Sec.	S _____ T _____ R _____	_____
	S _____ T _____ R _____	_____

Register's Office }  
Gogebic County } ss.

Received for record the  
19<sup>th</sup> day of OCTOBER  
A. D. 1995 at 10:10 o'clock  
A m., and recorded in  
Liber 5 of CORNERS  
on page 300

Ramona Collins, Deputy  
Register of Deeds

Register of Deeds Stamp & File Number

4. Lot No. \_\_\_\_\_, Recorded Plat \_\_\_\_\_  
5. Private Claims \_\_\_\_\_  
One-quarter corner to Sections 18 & 19, T47N, R46W

	A	B	C	D	E	F	G	H	I	J	K	L	M
2	6	5	4	3	2	1							
3													
4	7	8	9	10	11	12							
5													
6	18	17	16	15	14	13							
7	●												
8	19	20	21	22	23	24							
9													
10	30	29	28	27	26	25							
11													
12	31	32	33	34	35	36							
13													

I, John R. Garske, in a field survey on October 16, 1995, do hereby certify that under requirements of P.A. 74, Michigan P.A. of 1970, the corner points mentioned in lines 1 and 2 above were in conformance with regulations and rules therefore as required in the current manual of survey instructions of the United States Department of the Interior, Bureau of Land Management or by a decree of a Court of Law and/or that the corner points mentioned in lines 3, 4 and 5 above were in conformance with the rules of the Michigan Board of Land Surveyors or by a Decree of a Court of Law; established, re-established, monumented, re-monumented, recovered, found as expressed below:

**NOTE: Not more than 4 corners, all in the same town and range, may be recorded on this certificate.**

A. Description of original monument and accessories and/or subsequent restoration:

- Original survey by Austin Burt, D.S., in 1851. Original bearing trees: Sugar 14" - S39°W - 29 links; Sugar 6" - N71°E - 36 links.

B. Description of corner evidence found and/or method applied in restoring or reestablishing corner:

The corner location falls in a cleared area at the Old Geneva Mine location, north of an old mine tailings pile and in between old abandoned railroad grades. Nothing could be found in the field to assist in determining the corner position so I re-established the corner by single proportional measurement between existing monumented corners in accordance with the original government notes for sections on the west end of a township. A post with a Keewenaw tag is N7°Wly - 30 feet±.

(Record research on file.)


C. Description of monument for corner and accessories established to perpetuate locating the position of the corner:

I set 3/4" diameter x 30" long iron rod with a 3 1/4" diameter stamped aluminum cap grouted in rock, from which I established the following bearing trees and/or bearing objects:

- 6' steel sign rail with sign - Due North - 11.48 feet
- 6' steel sign rail with sign - Due West - 10.20 feet
- 6' steel sign rail with sign - Due South - 12.05 feet
- S.W. corner of overhead powerline steel tower - N88°E - 109.60 feet
- No trees or other objects are within 150 feet of corner position.

PEER GROUP APPROVED

Richard H. Deahn 10/18/95  
COUNTY REPRESENTATIVE

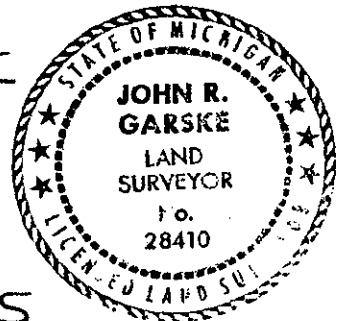

Signed by John R. Garske

Date 10-18-95

Surveyor's Michigan License No. 28410