

**LAND CORNER RECORDATION CERTIFICATE**  
**Filing Requirement of Act 74, Mich. P.A. 1970**

Register's Office }  
 Gogebic County } SS.

Received for record the  
21 day of SEPTEMBER  
 A. D. 1995 at 9:55 o'clock  
9 m., and recorded in  
 Liber 5 of CORNERS  
 on page 293  
Romona Collins, Deputy  
 Register of Deeds

For corners in

Gogebic Located In: Corner Code #  
 (County)

1. Public Land Survey T 47N R 46W C-1  
S-5 T 48N R 46W C-13  
 T \_\_\_\_\_ R \_\_\_\_\_  
 T \_\_\_\_\_ R \_\_\_\_\_

2. Property Controlling S \_\_\_\_\_ T \_\_\_\_\_ R \_\_\_\_\_  
 in Section S \_\_\_\_\_ T \_\_\_\_\_ R \_\_\_\_\_

3. Miscellaneous S \_\_\_\_\_ T \_\_\_\_\_ R \_\_\_\_\_  
 Property in Sec. S \_\_\_\_\_ T \_\_\_\_\_ R \_\_\_\_\_

Register of Deeds Stamp & File Number

4. Lot No. \_\_\_\_\_, Recorded Plat \_\_\_\_\_  
 5. Private Claims \_\_\_\_\_  
 Section corner common to Sections 5 and 6, T47N, R46W and  
 Sections 31 and 32, T48N, R46W.

I, John R. Garske, in a field survey on September 6, 19 95,  
 do hereby certify that under requirements of P.A. 74, Michigan P.A. of 1970, the corner points mentioned  
 in lines 1 and 2 above were in conformance with regulations and rules therefore as required in the  
 current manual of survey instructions of the United States Department of the Interior, Bureau of Land  
 Management or by a decree of a Court of Law and/or that the corner points mentioned in lines 3, 4 and 5  
 above were in conformance with the rules of the Michigan Board of Land Surveyors or by a Decree of a  
 Court of Law; established, re-established, monumented, re-monumented, recovered, found as  
 expressed below:

	A	B	C	D	E	F	G	H	I	J	K	L	I
2	6	5	4	3	2	1							
3													
4	7	8	9	10	11	12							
5													
6	18	17	16	15	14	13							
7													
8	19	20	21	22	23	24							
9													
10	30	29	28	27	26	25							
11													
12	31	32	33	34	35	36							
13													

**NOTE: Not more than 4 corners, all in the same town and range, may be recorded on this certificate.**

A. Description of original monument and accessories and/or subsequent restoration:

On September 9, 1847, William A. Burt established a 6" sugar as a corner tree, from which a 12" sugar bears N43°E, 36 links;  
 12" sugar - N12°W, 31 links  
 20" sugar - S55°E, 50 links  
 6" sugar - S53°W, 17 links

Survey by William Riipi, RLS, dated 4-5-76 - Found 1" iron pin at corner location Plat of Big Powderhorn Mountain.

B. Description of corner evidence found and/or method applied in restoring or reestablishing corner:

No corner evidence of the corner could be found due to ski hill construction. I was able to reestablish the corner position by use of recorded plats and survey information provided by Riipi. Including dimension shown on the Plat of Alpen Village and monuments found within the Plat.

Corner record research on file with County Register of Deeds.


C. Description of monument for corner and accessories established to perpetuate locating the position of the corner:

Set a 3/4" diameter x 14" long aluminum rod with a 3 1/4" diameter aluminum cap grouted in rock, stamped: County Remonumentation; T48N, R46W; S-31; S-32; S-6; S-5; T47N; 1995; RLS 28410, from which I established the following bearing trees and/or reference objects:

Light pole - N19°E, 95.76 feet  
 Light pole - S41°W, 111.90 feet  
 7" aspen - S67°E, 140.45 feet  
 5" sugar - N45°W, 48.30 feet

PEER GROUP APPROVED

Richard G. Walsh 9/20/95  
 COUNTY REPRESENTATIVE

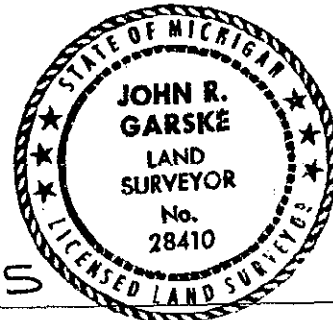

Signed by John R. Garske  
 Surveyor's Michigan License No. 28410

Date 9-15-95