

LAND CORNER RECORDATION CERTIFICATE
Filing Requirement of Act 74, Mich. P.A. 1970

Register's Office }
 Gogebic County } ss.

For corners in
Gogebic
 (County)

Located In: Corner Code #

Received for record the
12TH day of MAY
 A. D. 1995 at 11:20 o'clock
A m., and recorded in
 Liber 5 of CORNERS
 on page 261
Raymond Collins Deputy
 Register of Deeds

- | | | |
|------------------------------------|---------------------------|------------|
| 1. Public Land Survey | T <u>47N</u> R <u>46W</u> | <u>C-7</u> |
| | T _____ R _____ | _____ |
| | T _____ R _____ | _____ |
| | T _____ R _____ | _____ |
| 2. Property Controlling in Section | S _____ T _____ R _____ | _____ |
| | S _____ T _____ R _____ | _____ |
| 3. Miscellaneous Property in Sec. | S _____ T _____ R _____ | _____ |
| | S _____ T _____ R _____ | _____ |

Register of Deeds Stamp & File Number

4. Lot No. _____, Recorded Plat _____
 5. Private Claims _____
 Sec. Cor. Comm. to Sec's. 17,18,19 & 20

A	B	C	D	E	F	G	H	I	J	K	L	M
2	6	5	4	3	2	1						
3												
4	7	8	9	10	11	12						
5												
6	18	17	16	15	14	13						
7		●										
8	19	20	21	22	23	24						
9												
10	30	29	28	27	26	25						
11												
12	31	32	33	34	35	36						
13												

I, John P. Goss, in a field survey on April 30, 1995, do hereby certify that under requirements of P.A. 74, Michigan P.A. of 1970, the corner points mentioned in lines 1 and 2 above were in conformance with regulations and rules therefore as required in the current manual of survey instructions of the United States Department of the Interior, Bureau of Land Management or by a decree of a Court of Law and/or that the corner points mentioned in lines 3, 4 and 5 above were in conformance with the rules of the Michigan Board of Land Surveyors or by a Decree of a Court of Law; established, re-established, monumented, re-monumented, recovered, found as expressed below:

NOTE: Not more than 4 corners, all in the same town and range, may be recorded on this certificate.

A. Description of original monument and accessories and/or subsequent restoration:
 Original Survey by Austin Burt on 17 of June in 1851. Set Post.
 Original Bearing Trees: Sugar 12"-S46°E-27 links; Sugar 6"-N68°W-15 links.


John R. Garske in 1991 using Oliver Mining Co. noted found 3/4" iron pin as called for in field notes. Accepted same as corner and recorded it in Liber 4 page 3 of Land Corners for Gogebic County: 14" Maple-S78°E-46.76; Twin 8" Maple-S20°W- 24.62'; Bottom Bolt of SE leg of Elec. Tower- Due West- 82.76'.

B. Description of corner evidence found and/or method applied in restoring or reestablishing corner:
 I found the 3/4 inch iron pin as called for in John R. Garske certification. It was bended over in a rock pile. I updated the corner monument and accessories as noted below to state and county specification.
 Act 74 reseach on file with the County Register of Deeds Office.

PEER GROUP APPROVED
Richard H. Drake 5/11/95
 COUNTY REPRESENTATIVE

C. Description of monument for corner and accessories established to perpetuate locating the position of the corner:
 I placed a 5/8" x 24" rebar along side the bended 3/4" iron pin in the rock pile. On top of the 5/8" rebar I placed a 3 1/2" aluminum cap stamed as follows: County Remonumentation; S-17; S-18; S-19; S-20; T.47 N., R.46 W.; 1995; P.S. 23509. I established the following bearing trees and reference objects.

- | | | | |
|---|----------|--------|--|
| 14" Maple | S 78° E | 46.76' | |
| Twin 8" Maples | S 02° W | 24.62' | |
| Bottom bolt on Southeast leg of electric transmission tower | Due West | 82.76' | |
| 6' Steel Rail and Sign | N 20° E | 2.15' | |

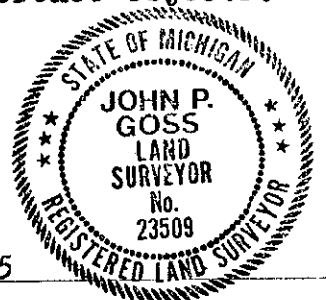

Signed by John P. Goss Date May 1, 1995
 Surveyor's Michigan License No. P.S. 23509