

OCT 18 1996

COMMISSION

**LAND CORNER RECORDATION CERTIFICATE**  
**Filing Requirement of Act 74, Mich. P.A. 1970**

For corners in Gogebic (County)	Located In:	Corner Code #
1. Public Land Survey	T 47N R 46W	C-8
Section 20	T _____ R _____	_____
	T _____ R _____	_____
2. Property Controlling in Section	S _____ T _____ R _____	_____
3. Miscellaneous Property in Section	S _____ T _____ R _____	_____

Register's Office }  
 Gogebic County } **REG.**

Received for record the  
16<sup>th</sup> day of August  
 A. D. 1996 at 10:45 o'clock  
A m., and recorded in  
 Liber 6 of COMMERCE  
 on page 7  
*Sandra Collins Deputy*  
 Register of Deeds

Register of Deeds Stamp & File Number

4. Lot No. \_\_\_\_\_, Recorded Plat \_\_\_\_\_  
 5. Private Claims \_\_\_\_\_

1/4 Section corner to Sections 19, & 20, T47N, R46W.

I, John R. Garske, in a field survey on June 18, 1996, do hereby certify that under requirements of P.A. 74, Michigan P.A. of 1970, the corner points mentioned in lines 1 and 2 above were in conformance with regulations and rules therefore as required in the current manual of survey instructions of the United States Department of the Interior, Bureau of Land Management or by a decree of a Court of Law and/or that the corner points mentioned in lines 3, 4 and 5 above were in conformance with the rules of the Michigan Board of Professional Surveyors or by a Decree of a Court of Law; established, re-established, monumented, re-monumented, recovered, found as expressed below:

**NOTE: Not more than 4 corners, all in the same town and range, may be recorded on this certificate.**

A	B	C	D	E	F	G	H	I	J	K	L	M
2	6	5	4	3	2	1						
3												
4	7	8	9	10	11	12						
5												
6	18	17	16	15	14	13						
7												
8	19	20	21	22	23	24						
9												
10	30	29	28	27	26	25						
11												
12	31	32	33	34	35	36						

**A. Description of original monument and accessories and/or subsequent restoration:**

- Original survey by Austin Burt, D.S., in 1851. He set a wood post from which: 10" y Birch - S35°W - 24 links and 12" Fir - N54°E - 17 links.
- Undated information from Gogebic County Road Commission indicates a corner at this position with a dimension south to a monumented corner at Sections 19,20,29, &30 of 2621.4 feet


**B. Description of corner evidence found and/or method applied in restoring or reestablishing corner:**

I found a 1" diameter iron pipe buried 18" beneath the gravel surface of the centerline of N. Geneva Road at the point of intersection with an old fence line running east. The centerline of Birch Road intersects N. Geneva Road approximately 4 feet North of the iron pipe. This position fits well with local occupation lines and I am accepting it as 1/4 corner. Measured 2620.44 feet south to the corner of 10,20,29, &30..

Record research on file.

I updated the corner position to state and county specifications as noted below.

**PEER GROUP APPROVED**  
*Richard P. Wilson 8/14/96*  
 COUNTY REPRESENTATIVE

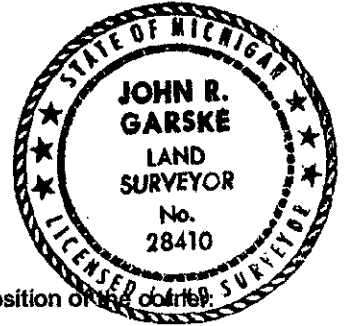

**C. Description of monument for corner and accessories established to perpetuate locating the position of the corner:**

At the iron pipe location I set a 5/8"x 24" rebar capped with a 3 1/4" diameter brass cap stamped to read: County Remonumentation; T47N, R46W; 1/4, S-19, S-20, 1996, RLS 28410, from which I established the following bearing trees:

- Light pole-N71°W-105.52 feet
- NE foundation corner of garage-S38°W-100.28 feet
- 10" B. Ash-S88°E-71.49 feet

Reference monument consisting of a 2 1/2" diameter x 30" long aluminum pipe with a 3 1/4" diameter aluminum cap stamped: County Remonumentation; T47N, R46W, R.M., S-19, S-20, 1/4, 1996, RLS 28410, S39°W, 38.70 feet; with a six foot steel rail with a sign-1.46 feet away.

Signed by *John R. Garske* Date 8-4-96  
 Surveyor's Michigan License No. 28410