

SURVEY & REMONUMENTATION

OCT 03 1996

COMMISSION

LAND CORNER RECORDATION CERTIFICATE
Filing Requirement of Act 74, Mich. P.A. 1970

For corners in Gogebic
 (County)

Located in:

Corner Code #

- | | | | | | |
|--------------------------------------|---|-----|---|-----|------|
| 1. Public Land Survey Section 30 | T | 47N | R | 46W | C-10 |
| | T | | R | | |
| | T | | R | | |
| | T | | R | | |
| 2. Property Controlling in Section | S | | T | R | |
| | S | | T | R | |
| 3. Miscellaneous Property in Section | S | | T | R | |
| | S | | T | R | |

Register's Office }
 Gogebic County } ss.

Received for record the
16TH day of AUGUST
 A. D. 1996 at 10:45 o'clock
A m., and recorded in
 Liber 6 of CORNERS
 on page 9
Rumera Collins, Deputy
 Register of Deeds

Register of Deeds Stamp & File Number

4. Lot No. _____, Recorded Plat _____
 5. Private Claims _____
 One-quarter Sections 29 and 28, T47N, R46W.

A	B	C	D	E	F	G	H	I	J	K	L	M
2	6	5	4	3	2	1						
3												
4	7	8	9	10	11	12						
5												
6	18	17	16	15	14	13						
7												
8	19	20	21	22	23	24						
9												
10	30	29	28	27	26	25						
11												
12	31	32	33	34	35	36						
13												

I, John R. Garske, in a field survey on June 27, 1996, do hereby certify that under requirements of P.A. 74, Michigan P.A. of 1970, the corner points mentioned in lines 1 and 2 above were in conformance with regulations and rules therefore as required in the current manual of survey instructions of the United States Department of the Interior, Bureau of Land Management or by a decree of a Court of Law and/or that the corner points mentioned in lines 3, 4 and 5 above were in conformance with the rules of the Michigan Board of Professional Surveyors or by a Decree of a Court of Law; established, re-established, monumented, re-monumented, recovered, found as expressed below:

NOTE: Not more than 4 corners, all in the same town and range, may be recorded on this certificate.

A. Description of original monument and accessories and/or subsequent restoration:

Original survey by Austin Burt in 1851. He set a post with witness trees: 14" sugar - S20°E - 8 links, 6" Ironwood - N38°W - 24 links.


B. Description of corner evidence found and/or method applied in restoring or reestablishing corner:

I established the corner position at the centerline of South Geneva Road opposite an ancient fence line running east. Measurements north and south to monumented corners were used to verify this post on which also fits well with local occupation lines.

(See sketch on back.)

Record Research on file.

PEER GROUP APPROVED
Richard P. Wrenn 8/14/96
 COUNTY REPRESENTATIVE

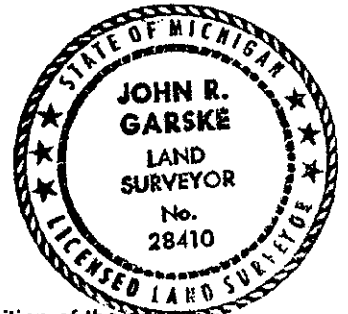

C. Description of monument for corner and accessories established to perpetuate locating the position of the corner:

I set a 5/8" rebar capped with a 3 1/4" diameter aluminum cap stamped: County Remonumentation, T47N, R46W, 1/4, S-29, S-30, 1996, R.L.S. 28410, from which I established the following reference objects and bearing trees:
 14" maple - N54°W - 61.13 feet
 7" maple - N31°E - 65.65 feet
 Power pole - S44°W - 45.52 feet
 Reference monument consisting of a 2 1/2" diameter x 30" aluminum pipe with a 3 1/4" diameter aluminum cap stamped: County Remonumentation, T47N, R46W, R.M., S-29, S-30, 1996, R.L.S. 28410, N37°W, 46.28 feet
 6' Steel rail with sign 2.1 feet away.

Signed by John R. Garske Date 8-4-96
 Surveyor's Michigan License No. 28410

SURVEY &
REMONUMENTATION


OCT 03 1996

COMMISSION

T.47N., R.46W.

C-10

SKETCH

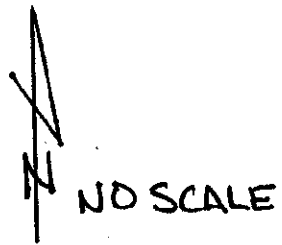

1/4 COR.
SECTIONS
29 & 30

