

SURVEY & MONUMENTATION

OCT 0 8 1996

LAND CORNER RECORDATION CERTIFICATE
Filing Requirement of Act 74, Mich. P.A. 1970

For corners in Gogebic (County) Located In: _____ Corner Code # _____

- | | | | |
|--------------------------------------|--------------|--------------|-------------|
| 1. Public Land Survey | T <u>47N</u> | R <u>46W</u> | <u>C-12</u> |
| Section 31 | T _____ | R _____ | _____ |
| | T _____ | R _____ | _____ |
| | T _____ | R _____ | _____ |
| 2. Property Controlling in Section | S _____ | T _____ | R _____ |
| | S _____ | T _____ | R _____ |
| 3. Miscellaneous Property in Section | S _____ | T _____ | R _____ |
| | S _____ | T _____ | R _____ |

Register's Office } ss.
Gogebic County }

Received for record the 16TH day of August A. D. 1996 at 10:45 o'clock A m., and recorded in Liber 6 of CORNERS on page 11
Ramona Collins Reppert
Register of Deeds

Register of Deeds Stamp & File Number

4. Lot No. _____, Recorded Plat _____
5. Private Claims _____

One-quarter corner to Sections 31 and 32, T47N, R46W.

I, John R. Garske, in a field survey on July 3, 1996, do hereby certify that under requirements of P.A. 74, Michigan P.A. of 1970, the corner points mentioned in lines 1 and 2 above were in conformance with regulations and rules therefore as required in the current manual of survey instructions of the United States Department of the Interior, Bureau of Land Management or by a decree of a Court of Law and/or that the corner points mentioned in lines 3, 4 and 5 above were in conformance with the rules of the Michigan Board of Professional Surveyors or by a Decree of a Court of Law; established, re-established, monumented, re-monumented, recovered, found as expressed below:

NOTE: Not more than 4 corners, all in the same town and range, may be recorded on this certificate.

A	B	C	D	E	F	G	H	I	J	K	L	M
2	6	5	4	3	2							
3												
4	7	8	9	10	11	12						
5												
6	18	17	16	15	14	13						
7												
8	19	20	21	22	23	24						
9												
10	30	29	28	27	26	25						
11												
12	31	32	33	34	35	36						
13												


A. Description of original monument and accessories and/or subsequent restoration:

Original survey by Austin Burt in 1851. He set a post with bearing trees: 24" yellow birch - S68°W - 15 links, 6" sugar - S56°E - 10 links.

PEER GROUP APPROVED
Richard L. Deaton 8/14/96
COUNTY REPRESENTATIVE

B. Description of corner evidence found and/or method applied in restoring or reestablishing corner:

I established the one-quarter corner at the centerline of South Geneva Road opposite an ancient fence line running ^{west.} east. The fence line consists of barb wire and post in the center of a major rock wall. Distances north (2632.67) and south (2636.93) to corner positions were also used to verify this location.

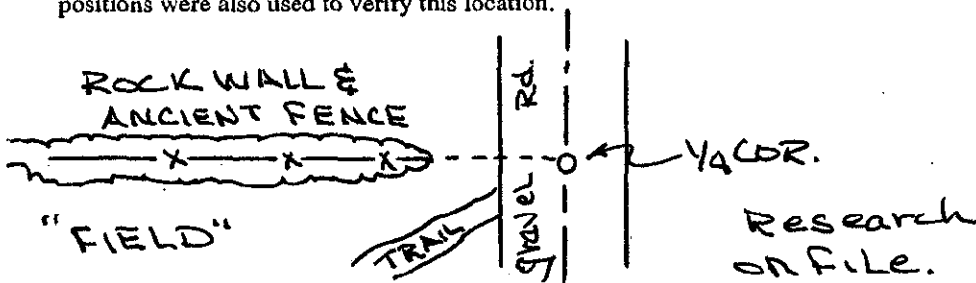

C. Description of monument for corner and accessories established to perpetuate locating the position of the corner:

I set a 5/8" x 30" rebar capped with a 3 1/4" diameter aluminum cap stamped: County remonumentation, T47N, R46W, 1/4, S-31, S-32, 1996, R.L.S. 28410, from which I established the following bearing trees and reference objects:
10" balsam - N41°E - 54.70 feet
10" maple - S55°E - 62.03 feet
7" elm - S57°W - 39.62 feet
Reference monument consisting of 2 1/2" diameter x 30" aluminum pipe with a 3 1/4" diameter aluminum cap stamped: County remonumentation, R.M., 1/4, T47N, R46W, S-31, S-32, 1996, R.L.S. 28410, S56°E, 34.30'
6' steel rail with sign 1.40 feet away.

Signed by John R. Garske Date 8-4-96
Surveyor's Michigan License No. 28410