

MAY 18 1987

COMMISSION

LAND CORNER RECORDATION CERTIFICATE
Filing Requirement of Act 74, Mich. P.A. 1970

Register's Office }
Gogebic County } ss.

For corners in Gogebic Located In: _____ Corner Code # _____
(County)

Received for record the
25TH day of NOVEMBER
A. D. 1996 at 10:50 o'clock
A m., and recorded in
Liber 6 of CORNERS
on page 82
Ramona Collins Deputy
Register of Deeds

- 1. Public Land Survey Section 32 T 47N R 46W C-13
T 46N R 46W C-1
T _____ R _____
T _____ R _____
- 2. Property Controlling in Section S _____ T _____ R _____
S _____ T _____ R _____
- 3. Miscellaneous S _____ T _____ R _____
Property in Section S _____ T _____ R _____

Register of Deeds Stamp & File Number

- 4. Lot No. _____, Recorded Plat _____
- 5. Private Claims _____

Section corner common to 31, 32, 5 & 6, T47-46N, R46W.

I, John R. Garske, in a field survey on October 22, 1996, do hereby certify that under requirements of P.A. 74, Michigan P.A. of 1970, the corner points mentioned in lines 1 and 2 above were in conformance with regulations and rules therefore as required in the current manual of survey instructions of the United States Department of the Interior, Bureau of Land Management or by a decree of a Court of Law and/or that the corner points mentioned in lines 3, 4 and 5 above were in conformance with the rules of the Michigan Board of Professional Surveyors or by a Decree of a Court of Law; established, re-established, monumented, re-monumented, recovered, found as expressed below:

	A	B	C	D	E	F	G	H	I	J	K	L	M
2	6		5		4		3		2		1		
3													
4	7		8		9		10		11		12		
5													
6	18		17		16		15		14		13		
7													
8	19		20		21		22		23		24		
9													
10	30		29		28		27		26		25		
11													
12	31		32		33		34		35		36		
13													

NOTE: Not more than 4 corners, all in the same town and range, may be recorded on this certificate.

A. Description of original monument and accessories and/or subsequent restoration:

On September 3, 1847, William A. Burt, U.S.D.S., set a cedar post from which:
20" sugar - N80°E - 31 links 12" Y. birch - N70°W - 2.5 links

B. Description of corner evidence found and/or method applied in restoring or reestablishing corner:


At the corner location, I found an intersection of ancient fence lines running north, east and west. Blue lines from cruisers run south and east from this location. Distances to known corner positions as shown on the sketch on the back check quite well with this position.

Record research on file. (Sketch on back)

PEER GROUP APPROVED
Richard L. Deahn 11/11/96
COUNTY REPRESENTATIVE

C. Description of monument for corner and accessories established to perpetuate locating the position of the corner:

I set a stamped 3 1/4" aluminum cap on a 3/4" diameter x 30" long iron rod grouted in bedrock from which I established the following bearing trees and/or objects:
6" ironwood - N21°W - 29.58 feet
8" maple - S77°E - 21.06 feet
6" ash - S64° - 27.02 feet
6' steel sign rail - S33°E - 1.22 feet

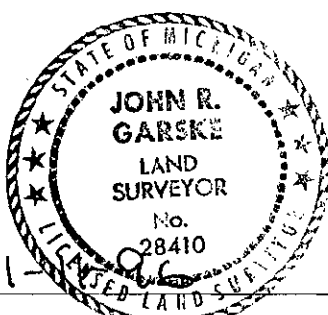

Signed by John R. Garske
Surveyor's Michigan License No. 28410

Date 11-11-96

SKETCH

30 29
31 32 T47N
R46W


S00°-29'-50"E
2632.67'

31 32 1/4 COR

N00°-23'-04"E
2636.93'

3CH. TOP OF HILL (M&R)
3CH. SOL. OUTCROP (M&R)
7CH. FOOT OF HILL (M&R)
GLO

31 32 T47N
2CH. 10 L. (M&R) TOP OF HILL
GLO
R46W T46N

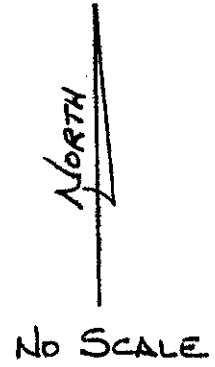

SURVEY &
REMONUMENTATIO

MAY 16 1987

CONVERSION

C-13

C-1