

LAND CORNER RECORDATION CERTIFICATE
Filing Requirement of Act 74, Mich. P.A. 1970

For corners in
Gogebic
(County)

Located In: _____ Corner Code # _____

1. Public Land Survey	Sec. 5	T 47N R 46W	D-1
	Sec. 32	T 48N R 46W	D-13
		T _____ R _____	
		T _____ R _____	
2. Property Controlling in Section	S _____	T _____ R _____	
	S _____	T _____ R _____	
3. Miscellaneous Property in Sec.	S _____	T _____ R _____	
	S _____	T _____ R _____	

4. Lot No. _____, Recorded Plat _____
 5. Private Claims _____

1/4 cor. comm. to Sec. 5, T.47N, R.46W.
 Sec. 32, T.48N, R.46W

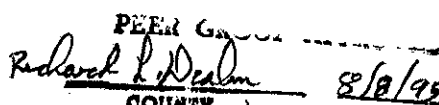
I, John P. Goss, in a field survey on July 29, 19 95, do hereby certify that under requirements of P.A. 74, Michigan P.A. of 1970, the corner points mentioned in lines 1 and 2 above were in conformance with regulations and rules therefore as required in the current manual of survey instructions of the United States Department of the Interior, Bureau of Land Management or by a decree of a Court of Law and/or that the corner points mentioned in lines 3, 4 and 5 above were in conformance with the rules of the Michigan Board of Land Surveyors or by a Decree of a Court of Law; established, re-established, monumented, re-monumented, recovered, found as expressed below:

NOTE: Not more than 4 corners, all in the same town and range, may be recorded on this certificate.

A. Description of original monument and accessories and/or subsequent restoration:
 Original corner established by William A. Burt in 1848. Set Hemlock post.
 Original bearing trees: Y. Birch 14" N 79° E 49 links
 Hemlock 14" N 09° W 21 links
 John R. Garske and John P. Goss in 1984 found 3/4" iron pipe in concrete checked with measurement to creek and several plats in area. They recorded this corner in Liber 2 on page 589 of Land Corners for Gogebic County. They established the following witnesses and distances. 14" Elm- N 80° W- 18.83'; 14" Maple- S 70° W- 21.36'; P.Pole S 03° W- 83.80'.

B. Description of corner evidence found and/or method applied in restoring or reestablishing corner:
 This corner was removed in construction in 1989. John R. Garske replaced this corner using plat monument in area in 1992. It checked with the call for creek and other plat ties. I updated the corner monument and accessories as noted below to state and county specification.

Act 74 reseach on file with the County Register of Dedds Office

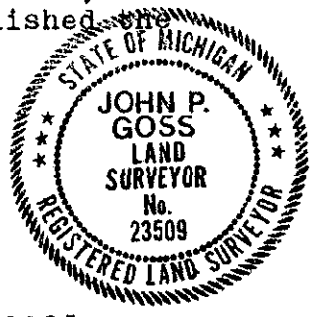

 COUNTY _____ 8/18/95

C. Description of monument for corner and accessories established to perpetuate locating the position of the corner:
 I cemented a 5/8 inch rebar 9 inches long into the rock outcrop. I placed a 3/4" aluminum cap on the 5/8" rebar stamped: County Remonumentation; T. 47-48 N; R.46 W., 1/4; S-32, S-5; 1995, P.S. 23509. I established the following bearing trees and reference objects.

- 6" Maple N 67° E 95.06'
- 12" Maple S 77° E 88.56'
- Conc. Mon. & 1/2" rebar. Due West 16.00'
- Railroad spike Due East 3.66'
- Reference Monument consisting of 2 1/2" x 30" aluminum monument with a 3/4" aluminum cap stamped to indicate corner position:

S 15° W-64.00' with 6" steel rail & sign-at 1.18'

Signed by John P. Goss Date July 31, 1995
 Surveyor's Michigan License No. P.S. 23509



Register's Office }
 Gogebic County } ss.
 Received for record the
14th day of AUGUST
 A. D. 1995 at 10:10 o'clock
A m., and recorded in
 Liber 5 of CORNERS
 on page 287
Ramona Collins, Deputy
 Register of Deeds

Register of Deeds Stamp & File Number

	A	B	C	D	E	F	G	H	I	J	K	L	M
2	6	5	4	3	2	1							
3													
4	7	8	9	10	11	12							
5													
6	18	17	16	15	14	13							
7													
8	19	20	21	22	23	24							
9													
10	30	29	28	27	26	25							
11													
12	31	32	33	34	35	36							
13													

