

**SURVEY &
REMONUMENTATION**

OCT 03 1996

COMMISSION

For corners in Gogebic
(County)

LAND CORNER RECORDATION CERTIFICATE
Filing Requirement of Act 74, Mich. P.A. 1970

Register's Office }
Gogebic County } ss.

Located In: _____ Corner Code # _____

1. Public Land Survey	T	<u>47N</u>	R	<u>46W</u>	<u>D-7</u>
	T	_____	R	_____	_____
	T	_____	R	_____	_____
	T	_____	R	_____	_____
2. Property Controlling In Section	S	_____	T	_____	R
	S	_____	T	_____	R
3. Miscellaneous Property in Section	S	_____	T	_____	R
	S	_____	T	_____	R

Received for record the
10TH day of JUNE
A. D. 1996 at 9:30 o'clock
A m., and recorded in
Liber 5 of CORNERS
on page 349
Ramona Collins Deputy
Register of Deeds

Register of Deeds Stamp & File Number

4. Lot No. _____, Recorded Plat _____
5. Private Claims _____

One-quarter corner to Sections 17 and 20, T47N, R46W

I, John R. Garske, in a field survey on May 29, 1996, do hereby certify that under requirements of P.A. 74, Michigan P.A. of 1970, the corner points mentioned in lines 1 and 2 above were in conformance with regulations and rules therefore as required in the current manual of survey instructions of the United States Department of the Interior, Bureau of Land Management or by a decree of a Court of Law and/or that the corner points mentioned in lines 3, 4 and 5 above were in conformance with the rules of the Michigan Board of Professional Surveyors or by a Decree of a Court of Law; established, re-established, monumented, re-monumented, recovered, found as expressed below:

NOTE: Not more than 4 corners, all in the same town and range, may be recorded on this certificate.

A	B	C	D	E	F	G	H	I	J	K	L	M
2	6	5	4	3	2	1						
3												
4	7	8	9	10	11	12						
5												
6	18	17	16	15	14	13						
7												
8	19	20	21	22	23	24						
9												
10	30	29	28	27	26	25						
11												
12	31	32	33	34	35	36						
13												

A. Description of original monument and accessories and/or subsequent restoration:

- Original survey by Austin Burt, D.S. on June 17, 1851.
- Original corner was a wood post from which:
Hemlock 22" - S28°E - 25 links (16.5')
Sugar 6" - N18°W - 15 links (9.90')

B. Description of corner evidence found and/or method applied in restoring or reestablishing corner:

I found no evidence of the original corner. I established the one-quarter corner position by single proportional measurement on line and half the distance between opposing section corners. This position landed at the intersection of an old rock fence running north and an ancient wire fence and rock wall running east.


(Record research on file)

PEER GROUP APPROVED
Richard P. Drake 6/6/96
COUNTY REPRESENTATIVE

C. Description of monument for corner and accessories established to perpetuate locating the position of the corner:

I set a 3/4" diameter by 36" long iron rod in very rocky ground with a 3 1/4" diameter aluminum cap stamped: "County Remonumentation", S-17, S-20, 1/4 cor., T47N, R46W, 1996, RLS 28410, from which I established the following bearing trees/objects:

- 6" spruce - N15°E - 30.21 feet
- 5" spruce - S35°E - 23.90 feet
- P. Pole - N83°W - 20.40 feet
- Steel sign post - S23°W - 1.37 feet

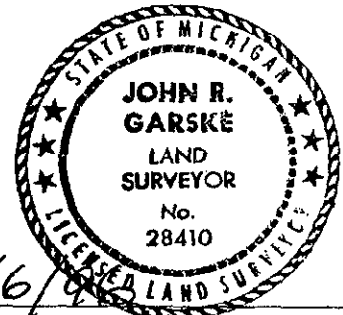

Signed by John R. Garske
Surveyor's Michigan License No. 28410

Date 6/6/96