LAND CORNER RECORDATION CERTIFICATE
Filing Requirement of Act 74, Mich. P.A. 1970

Register's Office } ss.
Gogebic County }

Received for record the 21st day of July A. D. 1995 at 1:40 o'clock P m., and recorded in Liber 5 of Corners page 275
Ramona Collins, Deputy
Register of Deeds

Register of Deeds Stamp & File Number

For corners in Gogebic (County)

	Located In:	Corner Code ##
1. Public Land Survey Sec. 20	T 47N R 46W	D-9
	T ___ R ___	
	T ___ R ___	
	T ___ R ___	
2. Property Controlling	S ___ T ___ R ___	
in Section	S ___ T ___ R ___	
3. Miscellaneous	S ___ T ___ R ___	
Property in Sec.	S ___ T ___ R ___	

4. Lot No. _____, Recorded Plat _____
5. Private Claims _____

1/4 corner comm. to Sec's. 20 and 29

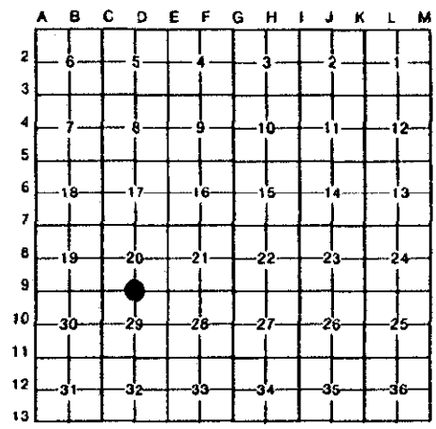

I, John P. Goss, in a field survey on June 23, 19 95, do hereby certify that under requirements of P.A. 74, Michigan P.A. of 1970, the corner points mentioned in lines 1 and 2 above were in conformance with regulations and rules therefore as required in the current manual of survey instructions of the United States Department of the Interior, Bureau of Land Management or by a decree of a Court of Law and/or that the corner points mentioned in lines 3, 4 and 5 above were in conformance with the rules of the Michigan Board of Land Surveyors or by a Decree of a Court of Law; established, re-established, monumented, re-monumented, recovered, found as expressed below:

NOTE: Not more than 4 corners, all in the same town and range, may be recorded on this certificate.

A. Description of original monument and accessories and/or subsequent restoration:

Original corner established by Austin Burt in June 1851. Corner was a 26" White Pine. Original bearing tree: Spruce 14"- S 05° E- 20 links.

John P. Goss in 1981 found a 1¼" iron pipe 4" under bit. surface of roadway and recorded it in Liber 2 on page 130 of Land Corners for Gogebic County. He established the following witnesses and distances: 4" Elm- N 08° W- 104.60'; T. Pole- S 48° E- 45.85'; 5" Elm- N 14° E- 75.92'.

B. Description of corner evidence found and/or method applied in restoring or reestablishing corner:

I found the iron pipe marking the corner position and it checked with the witnesses in John P. Goss certification. I updated the corner monument and accessories as noted below to state and county specification.

Act 74 reseach on file with the County Register of Deeds Office.

PEER GROUP APPROVED
Richard L. Dridan 7/10/95
COUNTY REPRESENTATIVE

C. Description of monument for corner and accessories established to perpetuate locating the position of the corner:

Set a 2½" brass cap with a 2" stem over the iron pipe at 1" below asphalt road surface. Cap is stamped T.47 N., R.46 W.; 1/4; S-20, S-29; 1995; P.S. 23509. I established the following bearing trees and reference objects.

7" Elm	N 14° E	75.92'
T. Pole	S 48° E	45.85'
4" Poplar	S 29° W	77.43'

Reference Monument consisting of a 2½" x 30" Aluminum monument with a 3¼" aluminum cap Stamped to indicate corner position: N 38° W - 37.39' with a steel rail and sign at 0.57'.

STATE OF MICHIGAN
JOHN P. GOSS
LAND SURVEYOR
No. 23509
REGISTERED LAND SURVEYOR

Signed by John P Goss Date June 24, 1995

Surveyor's Michigan License No. P. S. 23509

Fed. No. R-7

275

FORM APPROVED BY MICHIGAN STATE BOARD OF LAND SURVEYORS, JAN. 28, 1971
REVISED MAY 14, 1975
REVISED JAN., 1983