

SURVEY &
REMONUMENTATION

1993

COMMISSION

LAND CORNER RECORDATION CERTIFICATE
Filing Requirement of Act 74, Mich. P.A. 1970

For corners in

Gogebic
(County)

Located In:

Corner Code #

- | | | |
|------------------------------------|---------------------------|------------|
| 1. Public Land Survey Section 4 | T <u>47N</u> R <u>46W</u> | <u>E-2</u> |
| | T _____ R _____ | _____ |
| | T _____ R _____ | _____ |
| | T _____ R _____ | _____ |
| 2. Property Controlling in Section | S _____ T _____ R _____ | _____ |
| | S _____ T _____ R _____ | _____ |
| 3. Miscellaneous Property in Sec. | S _____ T _____ R _____ | _____ |
| | S _____ T _____ R _____ | _____ |

Register's Office }
Gogebic County } ss.

Received for record the
16th day of DECEMBER
A. D. 1993 at 2:25 o'clock
P m., and recorded in
Liber 4 of CORNER
on page 303
Betty Laaris, Deputy
Register of Deeds

Register of Deeds Stamp & File Number

4. Lot No. _____, Recorded Plat _____
5. Private Claims _____
- One-quarter corner S-4 & S-5.**

I, John R. Garske, in a field survey on December 2, 1993, do hereby certify that under requirements of P.A. 74, Michigan P.A. of 1970, the corner points mentioned in lines 1 and 2 above were in conformance with regulations and rules therefore as required in the current manual of survey instructions of the United States Department of the Interior, Bureau of Land Management or by a decree of a Court of Law and/or that the corner points mentioned in lines 3, 4 and 5 above were in conformance with the rules of the Michigan Board of Land Surveyors or by a Decree of a Court of Law; established, re-established, monumented, re-monumented, recovered, found as expressed below:

	A	B	C	D	E	F	G	H	I	J	K	L	M
2	6	5	4	3	2	1							
3													
4	7	8	9	10	11	12							
5													
6	18	17	16	15	14	13							
7													
8	19	20	21	22	23	24							
9													
10	30	29	28	27	26	25							
11													
12	31	32	33	34	35	36							
13													

NOTE: Not more than 4 corners, all in the same town and range, may be recorded on this certificate.

A. Description of original monument and accessories and/or subsequent restoration:

Original survey by Austin Burt U.S.D.S. on June 27, 1851. Set post at 38.56 CHS (north to south). Bearing trees:

- 6" Ironwood - S30°E - 11 links
- 14" Y. birch - West - 67 links
- No original evidence found.


B. Description of corner evidence found and/or method applied in restoring or reestablishing corner:

Found 1" iron rod in center of old two track road and on an old east-west fence line. Corner position is generally accepted and has been used as corner for 30+ years in many surveys of record. Including the subdivision of Section 5 for the recorded Plats of Creekside and Snow Summit.

C. Description of monument for corner and accessories established to perpetuate locating the position of the corner:

Replaced 1" iron rod with a 3/4" x 30" rebar with 3 1/2" aluminum cap stamped: County Remonumentation; T47N, R46W; 1/4 cor.; S-5; S-4; 1993; RLS 28410. Established the following bearing trees and/or reference objects:

- 6" sugar in clump of 3 - N32°E - 26.28 feet
- 8" sugar on fence line - S74°E - 15.14 feet
- 12" oak - N43°W - 21.00 feet
- Steel sign post - West - 7.80 feet

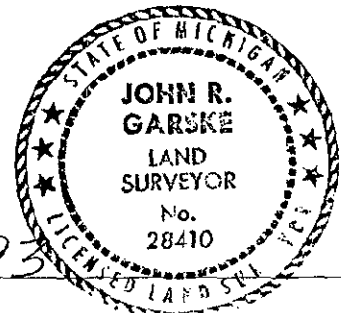

Signed by John R. Garske
Surveyor's Michigan License No. 28410

Date 12-9-93