

**LAND CORNER RECORDATION CERTIFICATE**  
**Filing Requirement of Act 74, Mich. P.A. 1970**

Register's Office }  
 Gogebic County } ss.

For corners in


<u>Gogebic</u> (County)	Located In:	Corner Code #
1. Public Land Survey Sec. 8	T <u>47N</u> R <u>46W</u>	<u>E-3</u>
	T _____ R _____	_____
	T _____ R _____	_____
	T _____ R _____	_____
2. Property Controlling in Section	S _____ T _____ R _____	_____
	S _____ T _____ R _____	_____
3. Miscellaneous Property in Sec.	S _____ T _____ R _____	_____
	S _____ T _____ R _____	_____

Received for record the  
19<sup>th</sup> day of OCTOBER  
 A. D. 1995 at 10:10 o'clock  
A m., and recorded in  
 Liber 5 of CORNERS  
 on page 298.

Ramona Collins, Deputy  
 Register of Deeds

Register of Deeds Stamp & File Number

4. Lot No. \_\_\_\_\_, Recorded Plat \_\_\_\_\_  
 5. Private Claims \_\_\_\_\_  
 Section corner common to Sections 4, 5, 8 and 9, T47N, R46W

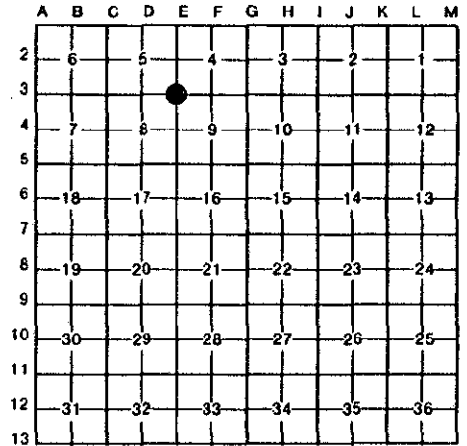

I, John R. Garske, in a field survey on October 16, 19 95, do hereby certify that under requirements of P.A. 74, Michigan P.A. of 1970, the corner points mentioned in lines 1 and 2 above were in conformance with regulations and rules therefore as required in the current manual of survey instructions of the United States Department of the Interior, Bureau of Land Management or by a decree of a Court of Law and/or that the corner points mentioned in lines 3, 4 and 5 above were in conformance with the rules of the Michigan Board of Land Surveyors or by a Decree of a Court of Law; established, re-established, monumented, re-monumented, recovered, found as expressed below:

**NOTE: Not more than 4 corners, all in the same town and range, may be recorded on this certificate.**

**A. Description of original monument and accessories and/or subsequent restoration:**

Original corner monumented by Austin Burt, D.S., on June 17, 1851.  
 Original bearing trees: Sugar 12" - S48°W - 6 links; Y. birch 14" - N15°E - 26 links.  
 1971 - Plat of Powderville Hamlet shows 1/4 corner to Sections 5 & 8 and 1/16 corner to 5 & 8.

**B. Description of corner evidence found and/or method applied in restoring or reestablishing corner:**

I used the found corner positions at the 1/4 corner and E 1/16 corner shown on the Powderville Plat to establish a mathematical position from which to search. The corner falls on the top of a high rock bluff. Using the natural feature calls; north 102.96 feet to top of hill, the 192.72 feet east to top of hill and the 345.84 feet call west to top of hill I verified and accepted the math position set from the extension of the plat line.


(Record research on file)

**C. Description of monument for corner and accessories established to perpetuate locating the position of the corner:**

I set a 3 1/4" diameter x 30" long iron rod with a 3 1/4" diameter stamped aluminum cap grouted into rock at the corner from which I established the following bearing trees and/or accessories:

- 7" sugar - S86°W - 10.79 feet
- 10" sugar - N69°E - 10.60 feet
- 9" sugar - S21°E - 41.24 feet

PEER GROUP APPROVED  
Richard K. Deakin 10/18/95  
 COUNTY REPRESENTATIVE

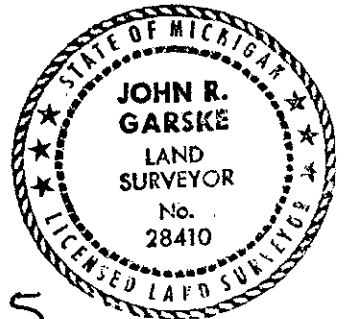

Signed by John R. Garske Date 10-18-95  
 Surveyor's Michigan License No. 28410