

**SURVEY &
REMONUMENTATION**

OCT 03 1996

COMMISSION

LAND CORNER RECORDATION CERTIFICATE
Filing Requirement of Act 74, Mich. P.A. 1970

For corners in <u>Gogebic</u> (County)	Located In:	Corner Code #
1. Public Land Survey	T 47N R 46W	E-6
	T _____ R _____	_____
Section 17	T _____ R _____	_____
	T _____ R _____	_____
2. Property Controlling in Section	S _____ T _____ R _____	_____
	S _____ T _____ R _____	_____
3. Miscellaneous Property in Section	S _____ T _____ R _____	_____
	S _____ T _____ R _____	_____

Register's Office }
Gogebic County } ss.

Received for record the
16TH day of AUGUST
A. D. 1996 at 10:45 o'clock
A m., and recorded in
Lib. b of CORNERS
on page 12
Ramon Collins Deputy
Register of Deeds

Register of Deeds Stamp & File Number

4. Lot No. _____, Recorded Plat _____
5. Private Claims _____

One quarter corner, Sections 16 and 17, T47N, R46W.

I, John R. Garske, in a field survey on July 3, 19 96, do hereby certify that under requirements of P.A. 74, Michigan P.A. of 1970, the corner points mentioned in lines 1 and 2 above were in conformance with regulations and rules therefore as required in the current manual of survey instructions of the United States Department of the Interior, Bureau of Land Management or by a decree of a Court of Law and/or that the corner points mentioned in lines 3, 4 and 5 above were in conformance with the rules of the Michigan Board of Professional Surveyors or by a Decree of a Court of Law; established, re-established, monumented, re-monumented, recovered, found as expressed below:

NOTE: Not more than 4 corners, all in the same town and range, may be recorded on this certificate.

	A	B	C	D	E	F	G	H	I	J	K	L	M
2	8		5		4		3		2		1		
3													
4	7		6		9		10		11		12		
5													
6	18		17		16		15		14		13		
7													
8	19		20		21		22		23		24		
9													
10	30		29		28		27		26		25		
11													
12	31		32		33		34		35		36		
13													

A. Description of original monument and accessories and/or subsequent restoration:

Original survey by Austin Burt, D.S., in 1851. He established a post at the 1/4 corner from which:
6" Y. birch - West - 13 links
10" Cedar - N70°E - 12 links

B. Description of corner evidence found and/or method applied in restoring or reestablishing corner:

No original or subsequent information on the corner location could be found. I established the corner by single proportional measurement. On line and equal distance between opposing section corners in accordance with the original government notes.

Record Research on file.


C. Description of monument for corner and accessories established to perpetuate locating the position of the corner:

I set a 2 1/2" diameter x 30" long aluminum pipe with a 3 1/4" diameter aluminum cap stamped: T47N, R46W, 1/4, S-17, S-16, 1996, R.L.S. 28410, from which I established the following reference objects and bearing trees:

- Power pole - S57°W - 30.64 feet
- 13" white ash - N69°W - 52.75 feet
- 9" white ash - N9°W - 21.40 feet
- 6' steel rail with sign - S64°E - 1.25 feet.

PEER GROUP APPROVED

Richard L. Wehr 01/14/96
COUNTY REPRESENTATIVE

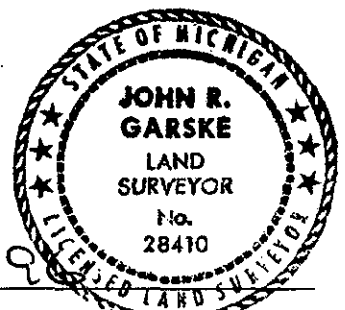

Signed by John R. Garske
Surveyor's Michigan License No. 28410

Date 8-4-96