

1993

COMMISSION

LAND CORNER RECORDATION CERTIFICATE
Filing Requirement of Act 74, Mich. P.A. 1970

For corners in
Gogebic
(County)

Located In:	Corner Code #/
1. Public Land Survey Section 4 T <u>47N</u> R <u>46W</u>	<u>F-3</u>
T _____ R _____	_____
T _____ R _____	_____
T _____ R _____	_____
2. Property Controlling S _____ T _____ R _____	_____
in Section S _____ T _____ R _____	_____
3. Miscellaneous S _____ T _____ R _____	_____
Property in Sec. S _____ T _____ R _____	_____

Register's Office }
Gogebic County } ss.

Received for record the
16th day of DECEMBER
A. D. 1993 at 2:25 o'clock
9 m., and recorded in
Liber 4 of CORNERS
on page 305.
Betty Lassin Deputy
Register of Deeds

Register of Deeds Stamp & File Number

- 4. Lot No. _____, Recorded Plat _____
- 5. Private Claims _____

One-quarter corner to S-4 & S-9, T47N, R46W.

December 2 93

I, John R. Garske, in a field survey on _____, 19_____, do hereby certify that under requirements of P.A. 74, Michigan P.A. of 1970, the corner points mentioned in lines 1 and 2 above were in conformance with regulations and rules therefore as required in the current manual of survey instructions of the United States Department of the Interior, Bureau of Land Management or by a decree of a Court of Law and/or that the corner points mentioned in lines 3, 4 and 5 above were in conformance with the rules of the Michigan Board of Land Surveyors or by a Decree of a Court of Law; established, re-established, monumented, re-monumented, recovered, found as expressed below:

	A	B	C	D	E	F	G	H	I	J	K	L	M
2	6		5		4		3		2				
3													
4	7		8		9		10		11		12		
5													
6	18		17		16		15		14		13		
7													
8	19		20		21		22		23		24		
9													
10	30		29		28		27		26		25		
11													
12	31		32		33		34		35		36		
13													

NOTE: Not more than 4 corners, all in the same town and range, may be recorded on this certificate.

A. Description of original monument and accessories and/or subsequent restoration:

Original survey by Austin Burt on June 17, 1851. Set post from which a 6" cedar bears S58°E, 16 links and a 6" cedar bears N71°W, 19 links. (No evidence found.)


B. Description of corner evidence found and/or method applied in restoring or reestablishing corner:

Found large spike at accepted corner position as used in previous surveys and by the Gogebic County Road Commission. I accepted this as the one-quarter corner as it has been used and accepted at its center line intersection location.

C. Description of monument for corner and accessories established to perpetuate locating the position of the corner:

Set standard 2 1/2" x 30" aluminum monument with an aluminum cap stamped: County Remonumentation; T47N, R46W; 1/4 cor.; S-4; S-9; 1993; RLS 28410. Established the following bearing trees and reference objects:

- Top of hydrant - S50°E - 27.70 feet
- Steel sign post - due south - 18.07 feet
- 14" maple - S82°W - 104.56 feet
- Old P. Pole #564 - N48°W - 37.57 feet
- New P. Pole #4-47/04 - N50°W - 35.99 feet

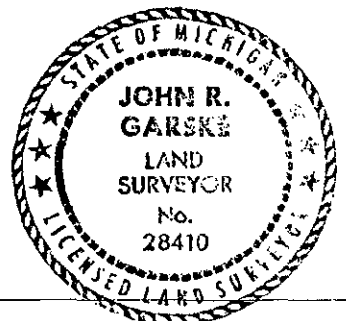

Signed by John R. Garske
Surveyor's Michigan License No. 28410

Date 12/9/93