Register's Office } ss.
Gogebic County }

Received for record the 21st day of July A. D. 1995 at 1:40 o'clock P m., and recorded in Liber 5 of CORNERS on page 277.

Ramona Collins, Deputy
Register of Deeds

Register of Deeds Stamp & File Number

LAND CORNER RECORDATION CERTIFICATE

Filing Requirement of Act 74, Mich. P.A. 1970

For corners in Gogebic (County)

	Located In:	Corner Code ##
1. Public Land Survey	Sec. 21 T 47N R 46W	F-9
	T ___ R ___	
	T ___ R ___	
	T ___ R ___	
2. Property Controlling	S ___ T ___ R ___	
in Section	S ___ T ___ R ___	
3. Miscellaneous	S ___ T ___ R ___	
Property in Sec.	S ___ T ___ R ___	

4. Lot No. _____, Recorded Plat _____
5. Private Claims _____

1/4 corner comm. to Sec's. 21 and 28

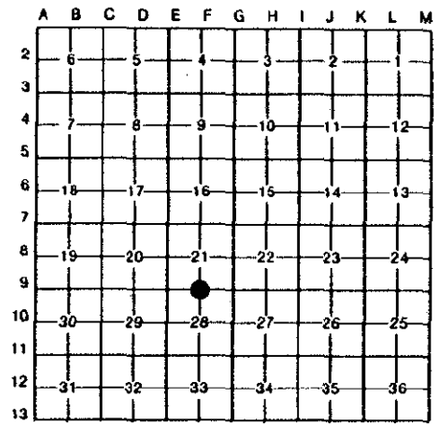

I, John P. Goss, in a field survey on June 17, 19 95, do hereby certify that under requirements of P.A. 74, Michigan P.A. of 1970, the corner points mentioned in lines 1 and 2 above were in conformance with regulations and rules therefore as required in the *current manual of survey instructions of the United States Department of the Interior, Bureau of Land* Management or by a decree of a Court of Law and/or that the corner points mentioned in lines 3, 4 and 5 above were in conformance with the rules of the Michigan Board of Land Surveyors or by a Decree of a Court of Law; established, re-established, monumented, re-monumented, recovered, found as expressed below:

NOTE: Not more than 4 corners, all in the same town and range, may be recorded on this certificate.

A. Description of original monument and accessories and/or subsequent restoration:

Original corner established by Austin Burt on June 16, 1851. Set post.
Original bearing trees: W. Pine 28" S 25° E 16 links
W. Pine 18" N 41° W 25 links.

John P. Goss in 1981 found iron pin in concrete monument and recorded it in Liber 2 on page 130 of Land Corners for Gogebic County, He established the following witnesses and distances. T. Pole- S 48° E- 35.09'; 10" Maple S 70° E 100.89'; N.E. Cor. store S 56° E- 94.16'.

B. Description of corner evidence found and/or method applied in restoring or reestablishing corner:

I found the concrete monument with 1/2 inch rebar marking the corner position and it checked with the witnesses in John P. Goss certification. I updated the corner monument and accessories as noted below to state and county specification.

Act 74 reseach on file with the County Register of Deeds Office.

PEER GROUP APPROVED
Richard L. Drake 7/18/95
COUNTY REPRESENTATIVE

C. Description of monument for corner and accessories established to perpetuate locating the position of the corner:

Set a 2½" brass cap with a 2" stem over the 1/2" rebar 1" below asphalt road surface. Cap is Stamped: T.47 N., R.46 W., 1/4; S-21, S-28; 1995; P.S. 23509.
I Established the following bearing trees and reference objects.

P.Pole	S 48° E 35.24'
12" Maple	S 70° E 101.10'
7" Spruce	S 17° W 96.33'
St. light	N 12° E 117.38'

Reference Monument consisting of a 2½" x 30" aluminum monument with a 3½" aluminum cap stamped to indicate corner position: N 48° W- 53.90' with a 6' steel rail with sign at 1.27'.

STATE OF MICHIGAN
JOHN P. GOSS
LAND SURVEYOR
No. 23509
REGISTERED LAND SURVEYOR

Signed by John P. Goss Date June 23, 1995

Surveyor's Michigan License No. P.S. 23509

Fed. No. R-11

FORM APPROVED BY MICHIGAN STATE BOARD OF LAND SURVEYORS, JAN. 28, 1971
REVISED MAY 14, 1975
REVISED JAN., 1983