

SURVEY & REMONUMENTATION COMMISSION
APR 07 1995

LAND CORNER RECORDATION CERTIFICATE
Filing Requirement of Act 74, Mich. P.A. 1970

Register's Office }
 Gogebic County } ss.

Received for record the
21ST day of OCTOBER
 A. D. 1994 at 11:15 o'clock
A m., and recorded in
 Liber 5 of CORNERS
 on page 150
Ramona Collins Deputy
 Register of Deeds

Register of Deeds Stamp & File Number

For corners in
Gogebic
 (County)

1. Public Land Survey Section 15	Located In: T <u>47N</u> R <u>46W</u>	Corner Code # <u>G-6</u>
	T _____ R _____	_____
	T _____ R _____	_____
	T _____ R _____	_____
2. Property Controlling in Section	S _____ T _____ R _____	_____
	S _____ T _____ R _____	_____
3. Miscellaneous Property in Sec.	S _____ T _____ R _____	_____
	S _____ T _____ R _____	_____

4. Lot No. _____, Recorded Plat _____
 5. Private Claims _____

	A	B	C	D	E	F	G	H	I	J	K	L	M
2	6	5	4	3	2	1							
3													
4	7	8	9	10	11	12							
5													
6	18	17	16	15	14	13							
7													
8	19	20	21	22	23	24							
9													
10	30	29	28	27	26	25							
11													
12	31	32	33	34	35	36							
13													

1/4 Cor. Comm. to sec's. 15 and 16

I, John P. Goss, in a field survey on August 28, 1994, do hereby certify that under requirements of P.A. 74, Michigan P.A. of 1970, the corner points mentioned in lines 1 and 2 above were in conformance with regulations and rules therefore as required in the current manual of survey instructions of the United States Department of the Interior, Bureau of Land Management or by a decree of a Court of Law and/or that the corner points mentioned in lines 3, 4 and 5 above were in conformance with the rules of the Michigan Board of Land Surveyors or by a Decree of a Court of Law; established, re-established, monumented, re-monumented, recovered, found as expressed below:

NOTE: Not more than 4 corners, all in the same town and range, may be recorded on this certificate.

A. Description of original monument and accessories and/or subsequent restoration:

Original survey by Austin Burt. Set a post. Original Bearing trees:
 12" Sugar- N87°W-6 links
 20" Y. Birch-S72°W-30 links.
 In 1851.

B. Description of corner evidence found and/or method applied in restoring or reestablishing corner:

No original evidence of the corner location could be found due to mining activity and logging.
 By using old map and distance on map from Joe Nespodzany (deceased) R.L.S. I found a concrete monument with 1/2" rebar. This monument checks with other survey made in area.


Act 74 research on file with County Register of Deeds Office.

PEER GROUP Approved
Richard L. Deahn 10/12/94

C. Description of monument for corner and accessories established to perpetuate locating the position of the corner:

I set a 2 1/2" x 30" aluminum pipe with a 3 1/4" aluminum cap stamped: 1/4, S-15, S-16, T47N, R46W, 1994, RLS 23509. I established the following bearing trees and reference objects.

- D.H. Nail & tag in P.Pole N65°W 74.11'
- D.H. Nail & tag in 16" N. Pine N40°E 3.17'
- D.H. Nail & tag in 12" N. Pine S53°E 9.00'
- D.H. Nail & tag in 9" N. Pine S19°W 39.85'
- Steel sign post- Due S- 1.7'

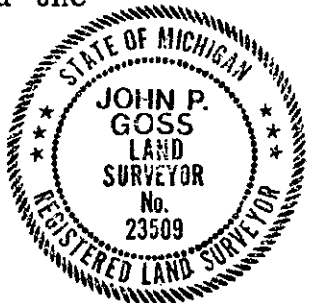

Signed by John P Goss Date 9-16-94
 Surveyor's Michigan License No. P.S. 23509