

**SURVEY & REMONUMENTATION**

OCT 0 8 1996

**LAND CORNER RECORDATION CERTIFICATE**  
**Filing Requirement of Act 74, Mich. P.A. 1970**

Register's Office }  
 Gogebic County } ss.

For corners in COMMISSION  
Gogebic  
 (County)

Located In: Corner Code #

1. Public Land Survey	T 47N R 46W	G-8
	T _____ R _____	_____
Section 21	T _____ R _____	_____
	T _____ R _____	_____
2. Property Controlling in Section	S _____ T _____ R _____	_____
	S _____ T _____ R _____	_____
3. Miscellaneous Property in Section	S _____ T _____ R _____	_____
	S _____ T _____ R _____	_____
4. Lot No. _____, Recorded Plat _____		
5. Private Claims _____		

Received for record the  
16<sup>th</sup> day of AUGUST  
 A. D. 1996 at 11:10 o'clock  
A m., and recorded in  
 Liber 6 of CORNERS  
 on page 17  
Ramona Collins, Deputy  
 Register of Deeds

Register of Deeds Stamp & File Number

Quarter corner to Sections 21 & 22, T47N, R46W.

I, John R. Garske, in a field survey on June 25, 1996, do hereby certify that under requirements of P.A. 74, Michigan P.A. of 1970, the corner points mentioned in lines 1 and 2 above were in conformance with regulations and rules therefore as required in the current manual of survey instructions of the United States Department of the Interior, Bureau of Land Management or by a decree of a Court of Law and/or that the corner points mentioned in lines 3, 4 and 5 above were in conformance with the rules of the Michigan Board of Professional Surveyors or by a Decree of a Court of Law; established, re-established, monumented, re-monumented, recovered, found as expressed below:

A	B	C	D	E	F	G	H	I	J	K	L	M
2	6		5		4		3		2		1	
3												
4	7		8		9		10		11		12	
5												
6	18		17		16		15		14		13	
7												
8	19		20		21	●	22		23		24	
9												
10	30		29		28		27		26		25	
11												
12	31		32		33		34		35		36	
13												

**NOTE: Not more than 4 corners, all in the same town and range, may be recorded on this certificate.**

**A. Description of original monument and accessories and/or subsequent restoration:**

- Original survey by Austin Burt, D.S., in 1851. He set a wood post from which: 12" Tamarack - S47°W - 22 links and 14" tamarack - N51°E - 37 links.
- 1921 - Gogebic Co. Rd. Commission - old notes indicate a corner.


**B. Description of corner evidence found and/or method applied in restoring or reestablishing corner:**

Due to farming and road construction, no evidence of the original corner or subsequent restorations exists. An old roadway centerline bears east a measured distance of 2634.83' north of the monumented corner 1/2 mile south. This roadway centerline and Johnson Road centerline intersection appears to be the best choice for the corner location and it matches well with local occupation lines. The 1.12 chain stream call north was checked and fits reasonably well with this position.

(See sketch on back)

Record research on file.

PEER GROUP APPROVED  
Richard R. Dreda 9/14/96  
 COUNTY REPRESENTATIVE

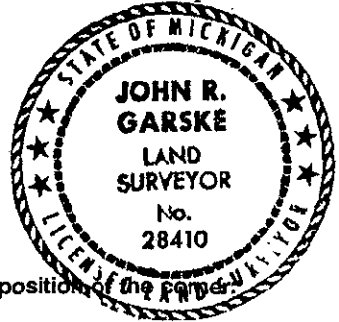

**C. Description of monument for corner and accessories established to perpetuate locating the position of the corner:**

I set a P.K. nail at the corner location from which I established the following bearing trees and/or reference objects:  
 Southernmost pole of 3 pole transmission line - N64°W - 79.12 feet  
 Reference monument consisting of a 2 1/2" diameter x 30" long aluminum pipe with a 3 1/4" diameter aluminum cap stamped: County Remonumentation: T47N, R46W, S-21, S-22, 1/4, 1996, R.M. R.L.S. 28410, N46°E, 44.75 feet.  
 Set 6 foot steel rail with sign 1.60 feet away.  
 Another reference monument stamped as above except N39°W, 48.01 feet.  
 Six foot steel sign rail with sign S39°E, 50.19 feet.

Signed by John R. Garske Date 8-4-96  
 Surveyor's Michigan License No. 28410

Faint, illegible text at the top of the page, possibly bleed-through from the reverse side.

SKETCH:  
NOT TO SCALE

T.47N., R.46W.  
G-8



R - RECORDED  
M - MEASURED

SURVEY &  
REMONUMENTATION  
OCT 6 8 1996  
COMMISSION

