

FEB 18 1994

COMMISSION

LAND CORNER RECORDATION CERTIFICATE
Filing Requirement of Act 74, Mich. P.A. 1970

For corners in

Gogebic (County)

Located In:

Corner Code #

- 1. Public Land Survey Section 3 T 47N R 46W H-3
2. Property Controlling in Section S T R
3. Miscellaneous Property in Sec. S T R

4. Lot No. , Recorded Plat

5. Private Claims

One-quarter corner common to S-3 & S-10, T47N, R46W.

I, John R. Garske, in a field survey on December 27, 1993, do hereby certify that under requirements of P.A. 74, Michigan P.A. of 1970, the corner points mentioned in lines 1 and 2 above were in conformance with regulations and rules therefore as required in the current manual of survey instructions of the United States Department of the Interior, Bureau of Land Management or by a decree of a Court of Law and/or that the corner points mentioned in lines 3, 4 and 5 above were in conformance with the rules of the Michigan Board of Land Surveyors or by a Decree of a Court of Law; established, re-established, monumented, re-monumented, recovered, found as expressed below:

NOTE: Not more than 4 corners, all in the same town and range, may be recorded on this certificate.

A. Description of original monument and accessories and/or subsequent restoration:

Survey by Austin Burt on June 13, 1851. Set wood post from which a 6" fir bears S15°W - 13 links and a 6" fir bears N66°E, 13 links.

B. Description of corner evidence found and/or method applied in restoring or reestablishing corner:

No original evidence found. I found a P.K. nail at corner location where an old East-West fence line and center line of Prospect Road would intersect. This corner location checks with area occupation lines currently existing harmoniously. It is shown on several surveys of record and I am accepting it as the most probable location of the true one-quarter corner.

Register's Office } ss.
Gogebic County }

Received for record this 30th day of December A. D. 1993 at 12:20 o'clock P. m., and recorded in Liber 4 of CORNERS

On page 324 Betty Soari, Deputy Register of Deeds


Register of Deeds Stamp & File Number

Grid table with columns A-M and rows 2-13. Contains numbers 1-36 in a grid pattern.

C. Description of monument for corner and accessories established to perpetuate locating the position of the corner:

From the found P.K. nail, I established the following bearing trees and reference objects:

- P. pole - S85°E - 28.54 feet
14" W. pine - N16°W - 115.41 feet
Reference monument - N43°E - 41.68 feet. Set 2 1/2" x 30" aluminum County Monument with a 3 1/2" stamped aluminum cap - steel sign post - 1.57 feet.
Reference monument - west - 24.76 feet. Set 2 1/2" x 30" aluminum County Monument with a 3 1/2" stamped aluminum cap - steel sign post - 1.02 feet.

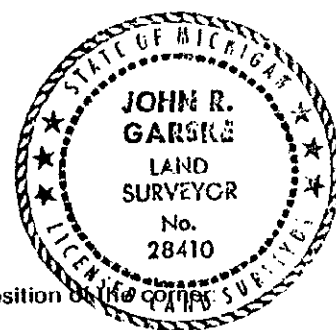

Signed by John R Garske
Surveyor's Michigan License No. 28410

Date 12/29/93