

SURVEY & MONUMENTATION
APR 07 1995
COMMISSION

LAND CORNER RECORDATION CERTIFICATE
Filing Requirement of Act 74, Mich. P.A. 1970

For corners in
Gogebic
(County)

Located In: _____ Corner Code # _____

- | | | | |
|------------------------------------|--------------|--------------|------------|
| 1. Public Land Survey | T <u>47N</u> | R <u>46W</u> | <u>H-5</u> |
| Section 10 | T _____ | R _____ | _____ |
| | T _____ | R _____ | _____ |
| | T _____ | R _____ | _____ |
| 2. Property Controlling in Section | S _____ | T _____ | R _____ |
| | S _____ | T _____ | R _____ |
| 3. Miscellaneous Property in Sec. | S _____ | T _____ | R _____ |
| | S _____ | T _____ | R _____ |
4. Lot No. _____, Recorded Plat _____
5. Private Claims _____

Register's Office }
Gogebic County } ss.

Received for record the
21st day of OCTOBER
A. D. 1994 at 11:15 o'clock
A m., and recorded in
Liber 5 of CORNERS
on page 151,
Ramona Collins, Deputy
Register of Deeds

Register of Deeds Stamp & File Number

1/4 cor. comm. to sec's. 10 & 15

I, John P. Goss, in a field survey on September 27, 19 94, do hereby certify that under requirements of P.A. 74, Michigan P.A. of 1970, the corner points mentioned in lines 1 and 2 above were in conformance with regulations and rules therefore as required in the current manual of survey instructions of the United States Department of the Interior, Bureau of Land Management or by a decree of a Court of Law and/or that the corner points mentioned in lines 3, 4 and 5 above were in conformance with the rules of the Michigan Board of Land Surveyors or by a Decree of a Court of Law, established, re-established, monumented, re-monumented, recovered, found as expressed below:

A	B	C	D	E	F	G	H	I	J	K	L	M
2	6	5	4	3	2	1						
3												
4	7	8	9	10	11	12						
5				15	14	13						
6	18	17	16	15	14	13						
7												
8	19	20	21	22	23	24						
9												
10	30	29	28	27	26	25						
11												
12	31	32	33	34	35	36						
13												

NOTE: Not more than 4 corners, all in the same town and range, may be recorded on this certificate.

A. Description of original monument and accessories and/or subsequent restoration:
Original survey by Austin Burt in 1851. Set post. Original bearing trees. Y. Birch 6"- S40°W- 7 links, Y. Birch 10"- N20°E- 37 links

In 1978 survey found a 1½" sq. iron bar. Said bar marked 10 and 15 on opposing sides. Bar also marked 1/4. It was recorded at this time in Liber 1 of Land Corners page 398 by Ewart C. Muller and John P. Goss, R.L.S. 15408 & R.L.S. 23509. Accessories: 10" Elm- Due N. - 2.39'; 20" Wild Cherry-S88°W- 19.55'; 6" Apple- S50°E- 19.60'.


B. Description of corner evidence found and/or method applied in restoring or reestablishing corner:
I found 1½" sq. iron bar as marked in Liber 1 of Land Corners page 398; this checked with stumps of witness trees. Therefore accepted as 1/4 corner position. I updated the corner monument and accessories as noted below to state and county specifications.

Act 74 research on file with the County Register of Deeds Office.

PEER GROUP **Approved**
Richard L. Deahn 10/12/94

C. Description of monument for corner and accessories established to perpetuate locating the position of the corner:
I set a 2½" x 30" long aluminum pipe with a 3¼" aluminum cap stamped: 1/4, S-10, S-15, T.47N., R.46 W., 1994, P.S. 23509, over the 1½" sq. iron bar that I found. I established the following bearing trees and reference objects.

- | | | |
|-----------------------------------|-------|--------|
| D.H. nail and tag in 14" N. Pine. | N36°E | 24.32' |
| D.H. nail and tag in 15" Poplar | S01°W | 51.47' |
| D.H. nail and tag in 8" Apple | N18°W | 34.25' |
| D.H. nail and tag in 9" Apple | S81°E | 33.62' |
| Steel sign post | Due N | 0.88' |

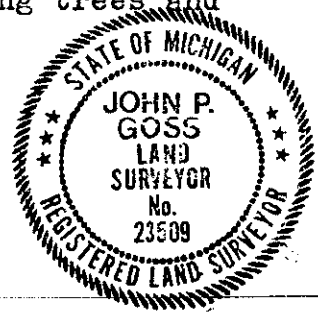

Signed by John P. Goss Date 9-28-94
Surveyor's Michigan License No. P.S. 23509