

**SURVEY & REMONUMENTATION**

**JAN 22 1998**

**SECTION**

**LAND CORNER RECORDATION CERTIFICATE**  
Filing Requirement of Act 74, Mich. P.A. 1970

Register's Office }  
Gogebic County } ss.

Received for record this  
24<sup>th</sup> day of NOVEMBER  
A. D. 1997 at 11:40 o'clock  
A m., and recorded in  
Liber 6 of CORNELS  
on page 270  
Ramona Collins Deputy  
Register of Deeds

For corners in  
Gogebic  
(County)

Located In:	Corner Code #
Section 22, 47W, 46W	H-7
T ___ R ___	_____
T ___ R ___	_____
T ___ R ___	_____
T ___ R ___	_____
S ___ T ___ R ___	_____
S ___ T ___ R ___	_____
S ___ T ___ R ___	_____
S ___ T ___ R ___	_____

Register of Deeds Stamp & File Number

4. Lot No. \_\_\_\_\_, Recorded Plat \_\_\_\_\_  
5. Private Claims \_\_\_\_\_  
1/4 corner sections 15 & 22, T47N, R46W

	A	B	C	D	E	F	G	H	I	J	K	L	M
1													
2	6		5		4		3		2		1		
3													
4	7		8		9		10		11		12		
5													
6	10		17		16		15		14		13		
7													
8	19		20		21		22		23		24		
9													
10	30		29		28		27		26		25		
11													
12	31		32		33		34		35		36		
13													

I, John R. Garske, in a field survey on October 23, 1997 do hereby state that under requirements of P.A. 74, Michigan P.A. of 1970, the corner points mentioned in lines 1 and 2 above were in conformance with regulations and rules therefore as required in the current manual of survey instructions of the United States Department of the Interior, Bureau of Land Management or by a decree of a Court of Law and/or that the corner points mentioned in lines 3, 4 and 5 above were in conformance with the rules of the Michigan Board of Land Surveyors or by a Decree of a Court of Law, established, re-established, monumented, recovered, found as expressed below:

NOTE: Not more than 2 corners, all in the same town and range, may be recorded on this certificate.

A. Description of original monument and accessories and/or subsequent restoration:

Original survey by Austin Burt, D.S. in 1851. He set a wood post from which:  
Spruce 16" S72°E 17 links  
Spruce 10" N28°W 48 links

B. Description of corner evidence found and/or method applied in restoring or reestablishing corner:


No evidence of the original corner position exists. I established the corner at the centerline intersection of Sartoris Road as it bends north and east. A woods line/fence line runs west from this position which checks with occupation fence lines north and east.

(Research on file)

**PEER GROUP APPROVED**  
Richard R. Deahn 11/11/97  
**COUNTY REPRESENTATIVE**

C. Description of monument for corner and accessories established to perpetuate locating the position of the corner:

I set a 2 1/2" dia. x 30" long alum. pipe with a 3 1/4" dia. alum. cap stamped to identify the corner, from which I established:  
14" Spruce N17°W 62.45 feet  
8" Apple S53°W 42.91 feet  
8" S. Maple S33°E 71.75 feet  
Steel Sign Rail N48°E 1.19 feet

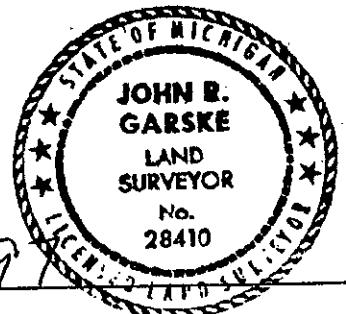

Signed by John R. Garske  
Surveyor's Michigan License No. 28410

Date 11/11/97