

**SURVEY & REMONUMENTATION**

OCT 03 1996

COMMISSION

**LAND CORNER RECORDATION CERTIFICATE**  
Filing Requirement of Act 74, Mich. P.A. 1970

Register's Office }  
Gogebic County } ss.

Received for record the  
16<sup>th</sup> day of AUGUST  
A. D. 1996 at 11:10 o'clock  
A m., and recorded in  
Lib. 6 of CORNERS  
on page 22  
Ramona Collins Deputy  
Register of Deeds

For corners in Gogebic (County) Located in: \_\_\_\_\_ Corner Code # \_\_\_\_\_

1. Public Land Survey	T <u>47N</u>	R <u>R46W</u>	<u>H-11</u>
	T _____	R _____	_____
Section 27	T _____	R _____	_____
	T _____	R _____	_____
2. Property Controlling in Section	S _____	T _____	R _____
	S _____	T _____	R _____
3. Miscellaneous Property in Section	S _____	T _____	R _____
	S _____	T _____	R _____

4. Lot No. \_\_\_\_\_, Recorded Plat \_\_\_\_\_

5. Private Claims \_\_\_\_\_

Register of Deeds Stamp & File Number

**Y4** Section corner to Sections 27, & 34, T47N, R46W.

I, John R. Garske, in a field survey on June 5, 1996, do hereby certify that under requirements of P.A. 74, Michigan P.A. of 1970, the corner points mentioned in lines 1 and 2 above were in conformance with regulations and rules therefore as required in the current manual of survey instructions of the United States Department of the Interior, Bureau of Land Management or by a decree of a Court of Law and/or that the corner points mentioned in lines 3, 4 and 5 above were in conformance with the rules of the Michigan Board of Professional Surveyors or by a Decree of a Court of Law; established, re-established, monumented, re-monumented, recovered, found as expressed below:

	A	B	C	D	E	F	G	H	I	J	K	L	M
2	6		5		4		3		2				
3													
4	7		8		9		10		11		12		
6													
8	18		17		16		15		14		13		
7													
8	19		20		21		22		23		24		
9													
10	30		29		28		27		26		25		
11													
12	31		32		33		34		35		36		
13													

**NOTE: Not more than 4 corners, all in the same town and range, may be recorded on this certificate.**

**A. Description of original monument and accessories and/or subsequent restoration:**

- Original survey by Austin Burt, D.S., in 1851. He found a 20" Y. Birch at the corner position from which he set: 12" Sugar - south - 20 links.
- USFS survey from 1935 found an iron peg in roadway in good condition with a metal location poster on NW side of a 6" fence post 4 feet high.


**B. Description of corner evidence found and/or method applied in restoring or reestablishing corner:**

I found a 3/4" diameter x 30" bent iron rod 18" below the surface of the roadway at the centerline intersections of Spruce and Elder Roads. Due to road construction and farming no original corner evidence exists. An old fenceline runs south from the iron rod location. I am accepting the found iron as the corner after measuring west to a known corner position at the intersection of Johnson and Spruce Roads.

Record research on file.

(See sketch on back)

I updated the corner position to state and county specifications as noted below.

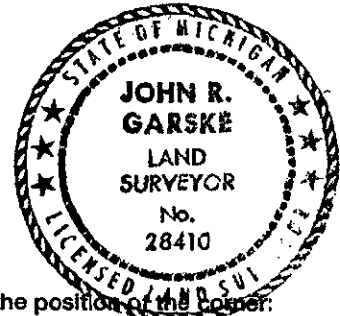

**C. Description of monument for corner and accessories established to perpetuate locating the position of the corner:**

I replaced the found iron rod with a 5/8" x 30" rebar capped with a 3 1/4" diameter brass cap stamped to read: T47N, R46W; 1/4, S-27, S-34, 1996, RLS 28410, 18" below the gravel surface from which I established the following bearing trees:

- Light pole-N43°E-43.32 feet
- 16" Sugar-S85°E-76.59 feet
- 16" Spruce-S03°-30'E-61.62 feet

Reference monument consisting of a 2-1/2" diameter x 30" long aluminum pipe with a 3 1/4" diameter aluminum cap stamped; County Remonumentation; T47N, R46W, R.M., S.27,S.34, 1/4, 1996, RLS 28410, S54°E, 52.15 feet, with a six foot steel rail with a sign-1.32 feet away.


PEER GROUP REPRESENTATIVE  
Richard P. Decker 8/14/96  
COUNTY REPRESENTATIVE

Signed by John R. Garske  
Surveyor's Michigan License No. 28410

Date 8-4-96

T. 47N., R. 46W.  
H-11

SKETCH  
NO SCALE

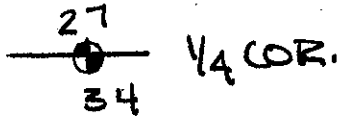

NOTE: BEARINGS  
ARE MAGNETIC.

