SURVEY & REMONUMENTATION

JUN 2 9 1995

COMMISSION

Register's Office } ss.
Gogebic County

Received for record the 12th day of April A. D. 1995 at 2:00 o'clock P m., and recorded in Liber 5 of Corners on page 248

Ramona Collins, Deputy
Register of Deeds

Register of Deeds Stamp & File Number

LAND CORNER RECORDATION CERTIFICATE

Filing Requirement of Act 74, Mich. P.A. 1970

For corners in Gogebic (County)

	Located In:	Corner Code ##
1. Public Land Survey	T 47N R 46W	J-5
	T ___ R ___	
	T ___ R ___	
	T ___ R ___	
2. Property Controlling	S ___ T ___ R ___	
in Section	S ___ T ___ R ___	
3. Miscellaneous	S ___ T ___ R ___	
Property in Sec.	S ___ T ___ R ___	

4. Lot No. _____, Recorded Plat _____
5. Private Claims _____

1/4 cor. comm. to Sec. 1, T.47 N., R.46 W
and Sec. 6, T.47 N., R.45 W.

I, John P. Goss, in a field survey on April 2, 19 95, do hereby certify that under requirements of P.A. 74, Michigan P.A. of 1970, the corner points mentioned in lines 1 and 2 above were in conformance with regulations and rules therefore as required in the current manual of survey instructions of the United States Department of the Interior, Bureau of Land Management or by a decree of a Court of Law and/or that the corner points mentioned in lines 3, 4 and 5 above were in conformance with the rules of the Michigan Board of Land Surveyors or by a Decree of a Court of Law; established, re-established, monumented, re-monumented, recovered, found as expressed below:

NOTE: Not more than 4 corners, all in the same town and range, may be recorded on this certificate.

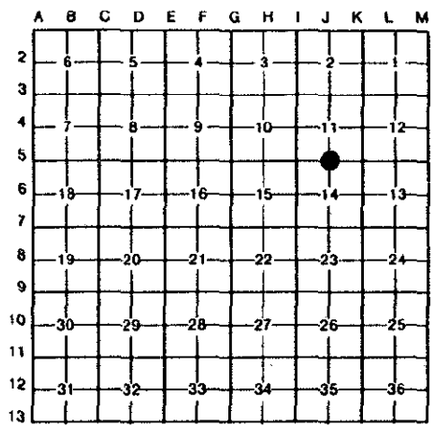

A. Description of original monument and accessories and/or subsequent restoration:

Original survey by Austin Burt on 19 of June in 1851. Set Post.
Original Bearing Trees:
16" Fir- S 58° W- 30 links.
6" Elm- N 46° E- 13 links.

In 1983 John P. Goss using MDOT witnesses found 1 inch iron rod buried 1 foot in ground. He recorded this corner in Liber 2 pages 430 and 431 of Gogebic County Land Corners: 9" Ash- S 19° W- 35.88'; 6" Maple- N 35° E 22.39'; 20" Elm- N 77°E- 22.43'.

B. Description of corner evidence found and/or method applied in restoring or reestablishing corner:

I found the 1 inch iron rod marking the corner position and it checked with witnesses in John P. Goss certification. I updated the corner monument and accessories as noted below to state and county spectification.

Act 74 reseach on file with the County Register of Deeds Office.

PEER GROUP APPROVED
Richard L. Dodson 4/6/95
COUNTY REPRESENTATIVE

C. Description of monument for corner and accessories established to perpetuate locating the position of the corner:

I placed a 2½" x 30" aluminum pipe with a 3¼" aluminum cap stamped: County Remonumentation, S-11, S-14; T 47 N; R 46 W; 1995; P.S. 23509. I established the following bearing trees and reference objects.

D.H. Nail in 12" Maple	N 35° E	22.30'
D.H. Nail in 4" Ash	N 54° W	16.08'
D.H. Nail in Tw. 7" Apple	S 33° W	52.81'
D.H. Nail in Tw. 6" Apple	S 33° E	48.29'
Steel Sign Post	Due N	1.00'

STATE OF MICHIGAN
JOHN P. GOSS
LAND SURVEYOR
No. 23509
REGISTERED LAND SURVEYOR

Signed by John P. Goss Date April 5, 1995

Surveyor's Michigan License No. P.S. 23509

FORM APPROVED BY MICHIGAN STATE BOARD OF LAND SURVEYORS, JAN. 28, 1971
REVISED MAY 14, 1975
REVISED JAN., 1983