SURVEY & REMONUMENTATION

OCT 0 3 1996

COMMISSION

LAND CORNER RECORDATION CERTIFICATE

Filing Requirement of Act 74, Mich. P.A. 1970

Register's Office } ss.
Gogebic County }

Received for record the 16TH day of August A. D. 19 96 at 11:10 o'clock A m., and recorded in Liber 6 of CORNERS on page 24.

Ramona Collins Deputy
Register of Deeds

Register of Deeds Stamp & File Number

For corners in Gogebic (County)

	Located In:	Corner Code #
1. Public Land Survey	T 47N R 46W	J-9
Section 23	T ___ R ___	
	T ___ R ___	
	T ___ R ___	
2. Property Controlling	S ___ T ___ R ___	
in Section	S ___ T ___ R ___	
3. Miscellaneous	S ___ T ___ R ___	
Property in Section	S ___ T ___ R ___	

4. Lot No. _____, Recorded Plat _____
5. Private Claims _____

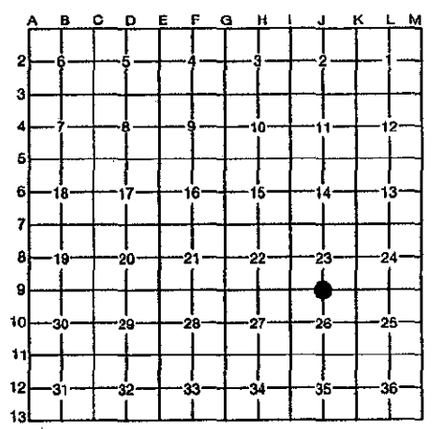

One quarter section corner common to Sections 23 and 26, T47N, R46W.

I, John R. Garske, in a field survey on July 17, 19 96, do hereby certify that under requirements of P.A. 74, Michigan P.A. of 1970, the corner points mentioned in lines 1 and 2 above were in conformance with regulations and rules therefore as required in the current manual of survey instructions of the United States Department of the Interior, Bureau of Land Management or by a decree of a Court of Law and/or that the corner points mentioned in lines 3, 4 and 5 above were in conformance with the rules of the Michigan Board of Professional Surveyors or by a Decree of a Court of Law; established, re-established, monumented, re-monumented, recovered, found as expressed below:

NOTE: *Not more than 4 corners, all in the same town and range, may be recorded on this certificate.*

A. Description of original monument and accessories and/or subsequent restoration:

- On June 12, 1851, Austin burt, U.S. Deputy Surveyor, set a post with a 14" cedar bearing S32°E - 45 links (29.70')
  14" cedar - N33°W - 22 links (14.52')

B. Description of corner evidence found and/or method applied in restoring or reestablishing corner:

I reestablished the corner position from the found B.T. now a 4 foot tall, 16" diameter cedar stub, bearing S32°E-29.70 feet. This corner position fits very well with the centerlines of Koski and Harding Roads. The distance east to the Black River and west to the bottom of hill, call is consistent with the originl survey notes.

Record Research on file.

STATE OF MICHIGAN
JOHN R. GARSKE
LAND SURVEYOR
No. 28410
LICENSED LAND SURVEYOR

C. Description of monument for corner and accessories established to perpetuate locating the position of the corner:

The corner position is marked by a 3 1/4" diameter aluminum cap atop a 5/8" x 24" rebar stamped: County Remonumentation, T47N, R46W, T46N, 1/4, S-23, S-26, 1996, R.L.S. 28410. The following reference objects were established:

2 1/2" diameter x 30" aluminum pipe with aluminum cap stamped: County Remonumentation, T47N, R46W, R.M., 1/4, S-23, S-26, R.L.S. 28410, S30°E, 43.22 with a steel sign rail 1.12' away.

6" cedar - N47°E - 40.37 feet
6" cedar - S33°E - 33.50 feet
12" spruce - S-75°W - 87.61 feet

PEER GROUP APPROVED
Richard L. Wrahn 8/14/96
COUNTY REPRESENTATIVE

Signed by John R Garske Date 8-4-96

Surveyor's Michigan License No. 28410

FORM APPROVED BY MICHIGAN STATE BOARD OF PROFESSIONAL SURVEYORS, JAN. 28, 1971
REVISED MAY 14, 1975
REVISED JAN., 1983

Fed. No. R-19