

**LAND CORNER RECORDATION CERTIFICATE**  
**Filing Requirement of Act 74, Mich. P.A. 1970**

Register's Office }  
 Gogebic County } ss.

Received for record the  
12<sup>TH</sup> day of MAY  
 A. D. 1995 at 11:20 o'clock  
A m., and recorded in  
 Liber 5 of CORNERS  
 on page 25B.

*Ramona Collins, Deputy*  
 Register of Deeds

Register of Deeds Stamp & File Number

For corners in

Gogebic  
 (County)

Located In:

Corner Code #

- |                                    |                           |            |
|------------------------------------|---------------------------|------------|
| 1. Public Land Survey              | T <u>47N</u> R <u>46W</u> | <u>K-5</u> |
|                                    | T _____ R _____           | _____      |
|                                    | T _____ R _____           | _____      |
|                                    | T _____ R _____           | _____      |
| 2. Property Controlling in Section | S _____ T _____ R _____   | _____      |
|                                    | S _____ T _____ R _____   | _____      |
| 3. Miscellaneous Property in Sec.  | S _____ T _____ R _____   | _____      |
|                                    | S _____ T _____ R _____   | _____      |

4. Lot No. \_\_\_\_\_, Recorded Plat \_\_\_\_\_  
 5. Private Claims \_\_\_\_\_

**Sec. Cor. Comm. to Sec's. 11,12,13 & 14**

I, John P. Goss, in a field survey on April 22, 19 95, do hereby certify that under requirements of P.A. 74, Michigan P.A. of 1970, the corner points mentioned in lines 1 and 2 above were in conformance with regulations and rules therefore as required in the current manual of survey instructions of the United States Department of the Interior, Bureau of Land Management or by a decree of a Court of Law and/or that the corner points mentioned in lines 3, 4 and 5 above were in conformance with the rules of the Michigan Board of Land Surveyors or by a Decree of a Court of Law, established, re-established, monumented, re-monumented, recovered, found as expressed below:

**NOTE: Not more than 4 corners, all in the same town and range, may be recorded on this certificate.**

	A	B	C	D	E	F	G	H	I	J	K	L	M
2	6		5		4		3		2		1		
3													
4	7		8		9		10		11		12		
5													
6	18		17		16		15		14		13		
7													
8	19		20		21		22		23		24		
9													
10	30		29		28		27		26		25		
11													
12	31		32		33		34		35		36		
13													

A. Description of original monument and accessories and/or subsequent restoration:

Original survey by Austin Burt on June 10, 1851. Set Post.  
 Original Bearing trees:

Spruce 8" S 38° E 32 links  
 Fir 16" N 03° W 8 links

John Garske found 1" iron rod at section corner location with corner identification scribed on it. He recorded this corner in 1989 in Liber 2 on page 507 of Land Corner for Gogebic County, 6" Maple-S60°W-22.59'; 6" Maple-S04°E-4.47'; 6" Maple-S50°E- 8.55'.

B. Description of corner evidence found and/or method applied in restoring or reestablishing corner:

I found the iron rod at section corner location with corner identification scribed on it and it checked with John Garske certification. I updated the corner monument and accessories as noted below to state and county specification.


Act 74 reseach on file with the County Register of Deeds Office.

PEER GROUP APPROVED  
*Richard L. Drizin 5/11/95*  
 COUNTY REPRESENTATIVE

C. Description of monument for corner and accessories established to perpetuate locating the position of the corner:

I placed a 2½" x 30" aluminum pipe with a 3¼" aluminum cap stamed as follows over the 1" iron rod: County Remonumentation; S-11; S-12; S-13; S-14; T.47 N., R.46 W.; 1995; P.S. 23509. I established the following bearing trees and reference objects.

9" Maple	S 60°W	22.59'
7" Maple	S 04°E	4.42'
9" Maple	S 50°E	8.55'
6' Steel rail and sign	N 16°W	1.54'

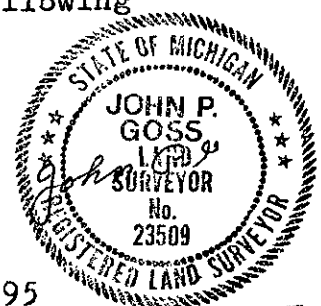

Signed by John P Goss

Date April 22, 1995

Surveyor's Michigan License No. P.S. 23509

Fed. J-21