

1993

COMMISSION

LAND CORNER RECORDATION CERTIFICATE  
Filing Requirement of Act 74, Mich. P.A. 1970

Register's Office }  
Gogebic County } ss.

For corners in

Gogebic  
(County)

Located In:

Corner Code #

- 1. Public Land Survey Section 13 T 47N R 46W Corner Code # K-6  
     T \_\_\_\_\_ R \_\_\_\_\_  
     T \_\_\_\_\_ R \_\_\_\_\_  
     T \_\_\_\_\_ R \_\_\_\_\_
- 2. Property Controlling S \_\_\_\_\_ T \_\_\_\_\_ R \_\_\_\_\_  
    in Section S \_\_\_\_\_ T \_\_\_\_\_ R \_\_\_\_\_
- 3. Miscellaneous S \_\_\_\_\_ T \_\_\_\_\_ R \_\_\_\_\_  
    Property in Sec. S \_\_\_\_\_ T \_\_\_\_\_ R \_\_\_\_\_

Received for record the  
16<sup>TH</sup> day of DECEMBER  
 A. B. 1993 at 2:30 o'clock  
P m., and recorded in  
 Liber 4 of CORNERS  
 on page 315  
*Betty Saari Deputy*  
 Register of Deeds

Register of Deeds Stamp & File Number

- 4. Lot No. \_\_\_\_\_, Recorded Plat \_\_\_\_\_
- 5. Private Claims \_\_\_\_\_

One-quarter corner common to S-14 & 13, T47N, R46W

I, John R. Garske, in a field survey on November 30, 1993, do hereby certify that under requirements of P.A. 74, Michigan P.A. of 1970, the corner points mentioned in lines 1 and 2 above were in conformance with regulations and rules therefore as required in the current manual of survey instructions of the United States Department of the Interior, Bureau of Land Management or by a decree of a Court of Law and/or that the corner points mentioned in lines 3, 4 and 5 above were in conformance with the rules of the Michigan Board of Land Surveyors or by a Decree of a Court of Law; established, re-established, monumented, re-monumented, recovered, found as expressed below:

NOTE: Not more than 4 corners, all in the same town and range, may be recorded on this certificate.

A. Description of original monument and accessories and/or subsequent restoration:

Survey by Austin Burt, U.S.D.S., June 18, 1851. Set post from which a 10" sugar bears S75°E, 8 links and a 10" Y. birch bears N62°W, 11 links. No original evidence found.

B. Description of corner evidence found and/or method applied in restoring or reestablishing corner:

Corner position destroyed and I restored corner position from found concrete monuments as shown on the recorded "Plat of Anvil", Bessemer Township, Gogebic County, MI.


C. Description of monument for corner and accessories established to perpetuate locating the position of the corner:

Set 3/4" x 30" rebar with 3 1/2" aluminum cap stamped: County Remonumentation; T47N, R46W; 1/4 cor.; S-13; S-14; 1993; RLS 28410. Established the following bearing trees and reference objects:

- P. Pole #14-92/45 - S78°W - 69.46 feet
- 10" maple in a clump - due east - 17.94 feet
- 9" ash - N39°W - 73.00 feet
- 8" ash - S23°E - 33.62 feet
- Steel sign rail - N81°E - 17.08 feet

Corner is 3" below gravel drive area currently being plowed.

Signed by John R. Garske Date 12/27  
 Surveyor's Michigan License No. 28410

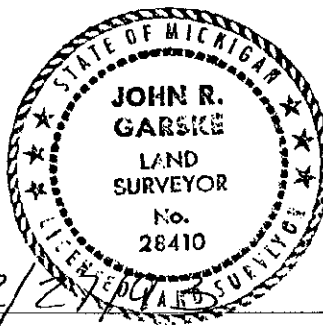

	A	B	C	D	E	F	G	H	I	J	K	L	M
2	6		5		4		3		2		1		
3													
4	7		8		9		10		11		12		
5													
6	18		17		16		15		14		13		
7													
8	19		20		21		22		23		24		
9													
10	30		29		28		27		26		25		
11													
12	31		32		33		34		35		36		
13													