

LAND CORNER RECORDATION CERTIFICATE
Filing Requirement of Act 74, Mich. P.A. 1970

Register's Office
Gogebic County

Received for record the
25TH day of AUGUST
A. D. 1900 at 1:20 o'clock
P m., and recorded in
Liber 8 of CORNERS
on page 12,
Ramona Collins Depute
Register of Deeds

Register of Deeds Stamp & File Number

For corners in

Gogebic
(County)

Located In:

Corner Code #

Sec. #2

1. Public Land Survey

T 47 N R 46 W

K-9

T ___ R ___

SURVEY &

T ___ R ___

REMONUMENTATION

T ___ R ___

2. Property Controlling
in Section

S ___ T ___ R ___

JAN 05 2001

S ___ T ___ R ___

3. Miscellaneous
Property in Sec.

S ___ T ___ R ___

SECTION

4. Lot No. _____, Recorded Plat _____
5. Private Claims _____

Section Corner 23, 24, 25 & 26; T.47 N., R.46 W.

I, Richard L. Drahn in a field survey on Aug. 19, 2000 do hereby state that under requirements of P.A. 74, Michigan P.A. of 1970, the corner points mentioned in lines 1 and 2 above were in conformance with regulations and rules therefore as required in the current manual of survey instructions of the United States Department of the Interior, Bureau of Land Management or by a decree of a Court of Law and /or that the corner points mentioned in lines 3, 4 and 5 above were in conformance with the rules of the Michigan Board of Land Surveyors or by a Decree of a Court of Law; established, re-established, monumented, recovered, found as expressed below:

NOTE: Not more than 2 corners, all in the same town and range, may be recorded on this certificate.

	A	B	C	D	E	F	G	H	I	J	K	L	M
1													
2	6	5	4	3	2	1							
3													
4	7	8	9	10	11	12							
5													
6	10	17	16	15	14	13							
7													
8	19	20	21	22	23	24							
9													
10	30	29	28	27	26	25							
11													
12	31	32	33	34	35	36							
13													

A. Description of original monument and accessories and/or subsequent restoration:

Original corner established by Austin Burt on 6/11/1851. Original B.T.s:
Y. Birch 16" S.63 W. 41 lks. Fir 12" N.45 E. 30 lks.

John R. Garske, RLS 28410, monumented this corner at the intersection of a fence line north and west and from 1935 USFS records; on 11/6/97. His B.T.s:
5" S. Maple N.76 E. 6.57' (dead) 5" Balsam S.38 W. 13.94'
7" S. Maple N.87 W. 12.54' (cut) 6' Sign rail S.04 E. 2.49'

Corner recorded in Gogebic County; Liber 6, Page 272 on 11/24/97.

B. Description of corner evidence found and/or method applied in restoring or reestablishing corner.


I recovered Garskes' monument, slightly bent from truck traffic and his B.T.s as referenced above. Road construction is due to bury the corner position and destroy Mr. Garske's remaining two bearing trees and the steel rail. After realigning the Monument I established three new bearing trees, re-set the steel sign rail and set a Reference Monument.

Corner research on file with Gogebic County records.

C. Description of monument for corner and accessories established to perpetuate locating the position of the corner:

From Mr. Garskes' 1997 monument I established the following bearing objects.

Y. Birch	9"	S.59 E.	16.82'
Sugar Maple (twin)	8"	S.22 W.	18.52'
Red Maple	10"	N.67 W.	37.29'
30" alum. Ref. Mon.		South	10.64'
Steel sign rail	6'	South	12.83'

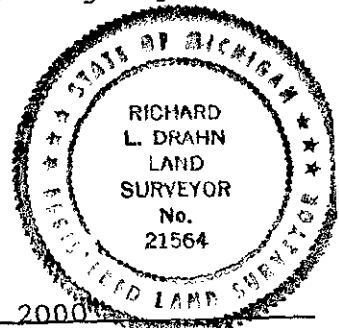

NEED GROUP APPROVED
Richard L. Drahn 8/23/00
COUNTY REGISTERED

Signed by Richard L. Drahn
Surveyor's Michigan License No. 21564

Date August 19, 2000