

SURVEY & REMONUMENTATION COMMISSION
APR 07 1995

LAND CORNER RECORDATION CERTIFICATE
Filing Requirement of Act 74, Mich. P.A. 1970

For corners in Gogebic (County) Located In: _____ Corner Code # _____

1. Public Land Survey T 47N R 47W B-1
 T _____ R _____
 T _____ R _____
 T _____ R _____

2. Property Controlling in Section S _____ T _____ R _____
 S _____ T _____ R _____

3. Miscellaneous Property in Sec. S _____ T _____ R _____
 S _____ T _____ R _____

Register's Office }
 Gogebic County } ss.
 Received for record the
16th day of December
 A. D. 1994 at 10:45 o'clock
A m., and recorded in
 Liber 5 of CORNERS
 on page 169.
Ramona Collins, Deputy
 Register of Deeds

Register of Deeds Stamp & File Number

4. Lot No. _____, Recorded Plat _____

5. Private Claims _____
 One-quarter corner common to Section 6, T47N, R47W and Section 48N, R47W.

	A	B	C	D	E	F	G	H	I	J	K	L	M
2	6	5	4	3	2	1							
3													
4	7	8	9	10	11	12							
5													
6	18	17	16	15	14	13							
7													
8	19	20	21	22	23	24							
9													
10	30	29	28	27	26	25							
11													
12	31	32	33	34	35	36							
13													

I, John R. Garske, in a field survey on December 7, 1994, do hereby certify that under requirements of P.A. 74, Michigan P.A. of 1970, the corner points mentioned in lines 1 and 2 above were in conformance with regulations and rules therefore as required in the current manual of survey instructions of the United States Department of the Interior, Bureau of Land Management or by a decree of a Court of Law and/or that the corner points mentioned in lines 3, 4 and 5 above were in conformance with the rules of the Michigan Board of Land Surveyors or by a Decree of a Court of Law; established, re-established, monumented, re-monumented, recovered, found as expressed below:

NOTE: Not more than 4 corners, all in the same town and range, may be recorded on this certificate.

A. Description of original monument and accessories and/or subsequent restoration:

Original survey by William Ives, Deputy Surveyor, in 1848. Original corner was a cedar post and original bearing trees are: Hemlock 12" - N33°E, 42 links (27.72'); Ironwood 8" - N62°W, 22 links (14.52')

B. Description of corner evidence found and/or method applied in restoring or reestablishing corner:


No original evidence could be found. Corner position was re-established on an ancient fence line and using single proportional measurement between the Montreal River west and the section corner to the east in conjunction with the original notes.

Record research form on file with County Register of Deeds office. See sketch on back.

PEER GROUP Approved
Richard P. Deaton 12/15/94

C. Description of monument for corner and accessories established to perpetuate locating the position of the corner:

Set a 2 1/2" x 30" aluminum monument with a 3 1/4" aluminum cap stamped: County Remonumentation; T48N, R47W, 1/4; S-31; S-6; T47; 1994; RLS 28410. Established the following bearing trees and reference object: 7" R. maple - S76°W, 3.74 feet; 5" sugar - S17°W, 13.47 feet; 7" sugar - S87°E, 13.80 feet; 6' steel rail with sign - north - 1.53 feet.

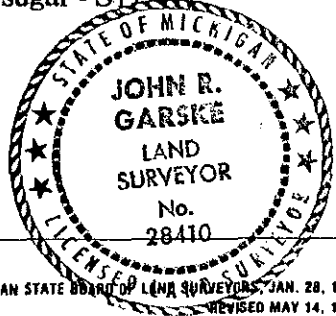

Signed by John R. Garske Date 12/14/94
 Surveyor's Michigan License No. 28410

MONTREAL RIVER

171.4' (M)
171.6' G.L.O.
171.4' (M)

2811.6' G.L.O.
2807.65' (M)

T48N, R47W

T47N, R47W

2640' G.L.O.
2636.29' (M)

NO SCALE
NORTH

31 | 32
6 | 5