

**SURVEY &  
REMONUMENTATION  
APR 07 1995  
COMMISSION**

**LAND CORNER RECORDATION CERTIFICATE  
Filing Requirement of Act 74, Mich. P.A. 1970**

Register's Office } ss.  
Gogebic County }

Received for record the  
16<sup>TH</sup> day of December  
A. D. 1994 at 10:45 o'clock  
A m., and recorded in  
Liber 5 of CORNERS  
on page 170  
Ramona Collins, Deputy  
Register of Deeds

Register of Deeds Stamp & File Number

For corners in  
Gogebic  
(County)

Located In: Corner Code #

1. Public Land Survey	T <u>47N</u> R <u>47W</u>	<u>C-1</u>
	T _____ R _____	_____
	T _____ R _____	_____
	T _____ R _____	_____
2. Property Controlling in Section	S _____ T _____ R _____	_____
	S _____ T _____ R _____	_____
3. Miscellaneous Property in Sec.	S _____ T _____ R _____	_____
	S _____ T _____ R _____	_____
4. Lot No. _____, Recorded Plat _____		
5. Private Claims _____		

Section corner common to Sections 5 and 6, T47N, R47W and  
Sections 31 and 32, T48N, R47W.

	A	B	C	D	E	F	G	H	I	J	K	L	M
2	6	5	4	3	2	1							
3													
4	7	8	9	10	11	12							
5													
6	18	17	16	15	14	13							
7													
8	19	20	21	22	23	24							
9													
10	30	29	28	27	26	25							
11													
12	31	32	33	34	35	36							
13													

I, John R. Garske, in a field survey on December 7, 1994, do hereby certify that under requirements of P.A. 74, Michigan P.A. of 1970, the corner points mentioned in lines 1 and 2 above were in conformance with regulations and rules therefore as required in the current manual of survey instructions of the United States Department of the Interior, Bureau of Land Management or by a decree of a Court of Law and/or that the corner points mentioned in lines 3, 4 and 5 above were in conformance with the rules of the Michigan Board of Land Surveyors or by a Decree of a Court of Law; established, re-established, monumented, re-monumented, recovered, found as expressed below:

**NOTE: Not more than 4 corners, all in the same town and range, may be recorded on this certificate.**

A. Description of original monument and accessories and/or subsequent restoration:

Original survey by William Ives, Deputy Surveyor, in 1848. Original corner was a maple post and original bearing trees are: Elm 12" - N66°E, 20 links (13.2'); B. ash 12" - N69°W, 25 links (16.5'); Maple 8" - S52°E, 26 links (17.16'); maple 10" - S21°W, 29 links.

D.S.S. & A. Railroad map dated June 30, 1916, shows corner position 145.4 feet east along tracks from center of bridge and 1340 feet north to corner.

B. Description of corner evidence found and/or method applied in restoring or reestablishing corner:

No original evidence could be found due to road construction. Corner was re-established at road centerline intersection which checks with fence line splits and measurements to corners to the east and west. The distance north to an ancient E-W fence checks within reason.

Record research form on file with County Register of Deeds office.

**PEER GROUP**


**Approved**

Richard L. Decker 12/15/94

C. Description of monument for corner and accessories established to perpetuate locating the position of the corner:

Set a 3/4" x 30" rebar with a 3 1/4" aluminum cap 6" below the gravel road surface stamped: County Remonumentation; T48N, R47W; S-31; S-32; S-6; S-5; T47N; 1994; RLS 28410. Established the following bearing trees and reference objects: Power pole - S08°W, 24.20 feet; Power pole - N53°W, 36.70 feet; 7" ash - N10°E, 133.48 feet; reference monument consisting of a 2 1/2" x 30" aluminum monument with a 3 1/4" aluminum cap stamped to indicate the corner position - S41°E, 31.47 feet with a 6' steel sign post - S41°E, 1.65 feet away.

Signed by John R. Garske Date 12/14/94  
Surveyor's Michigan License No. 28410

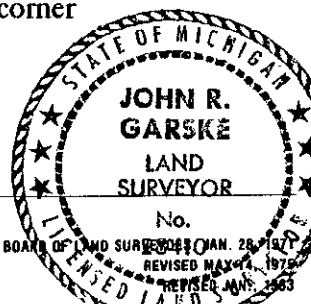

FORM APPROVED BY MICHIGAN STATE BOARD OF LAND SURVEYORS JAN. 28, 1977  
REVISED MAR. 1978