

LAND CORNER RECORDATION CERTIFICATE
Filing Requirement of Act 74, Mich. P.A. 1970

For corners in

<u>Gogebic</u> (County)	Located In:	Corner Code #
1. Public Land Survey	T <u>47N</u> R <u>47W</u>	<u>D-3</u>
	T _____ R _____	_____
	T _____ R _____	_____
	T _____ R _____	_____
2. Property Controlling in Section	S _____ T _____ R _____	_____
	S _____ T _____ R _____	_____
3. Miscellaneous Property in Sec.	S _____ T _____ R _____	_____
	S _____ T _____ R _____	_____

Register's Office }
 Gogebic County } ss.

Received for record the
21st day of JULY
 A. D. 1995 at 1:40 o'clock
P M., and recorded in
 Liber 5 of CORNERS
 on page 279
Ramona Collins, Deputy
 Register of Deeds

Register of Deeds Stamp & File Number

4. Lot No. _____, Recorded Plat _____
 5. Private Claims _____
 One-quarter corner common to Sections 5 and 8, T47N, R47W

A	B	C	D	E	F	G	H	I	J	K	L	M
2	6		5		4		3		2		1	
3			●									
4	7		8		9		10		11		12	
5												
6	18		17		16		15		14		13	
7												
8	19		20		21		22		23		24	
9												
10	30		29		28		27		26		25	
11												
12	31		32		33		34		35		36	
13												

I, John R. Garske, in a field survey on April 17, 19 95, do hereby certify that under requirements of P.A. 74, Michigan P.A. of 1970, the corner points mentioned in lines 1 and 2 above were in conformance with regulations and rules therefore as required in the current manual of survey instructions of the United States Department of the Interior, Bureau of Land Management or by a decree of a Court of Law and/or that the corner points mentioned in lines 3, 4 and 5 above were in conformance with the rules of the Michigan Board of Land Surveyors or by a Decree of a Court of Law; established, re-established, monumented, re-monumented, recovered, found as expressed below:

NOTE: Not more than 4 corners, all in the same town and range, may be recorded on this certificate.

A. Description of original monument and accessories and/or subsequent restoration:

- On August 30, 1848, William Ives set a post from which a 12" Y. birch bears S55°W, 21 links and a 10" sugar - N70°W, 21 links.

B. Description of corner evidence found and/or method applied in restoring or reestablishing corner:

No original evidence could be found due to road and utility construction and farming activity. I reestablished the corner at the intersection of a north-south fence line and the centerline of Greenfield Road. This corner position checks with measurements east to the section corner and lies in harmony with occupation lines and local residents.

Record research on file with Register of Deeds.


PEER GROUP APPROVED
Richard H. Deahn 7/10/95
 COUNTY REPRESENTATIVE

C. Description of monument for corner and accessories established to perpetuate locating the position of the corner:

I set a 3 1/4" diameter aluminum cap atop a 3/4" x 30" rebar cap is stamped: County Remonumentation; T47N, R47W; 1/4; S-5; S-8; 1995; RLS 28410. Corner is set 3" below gravel road surface from which I established the following bearing trees and/or reference objects:

- 4" twin basswood - N01°E - 30.05 feet
- 10" maple - N70°E - 54.09 feet
- P. pole #8-60/94 - S30°E - 25.15 feet
- A reference monument consisting of a 2 1/2" x 30" aluminum pipe with a 3 1/4" diameter aluminum cap atop it to indicate corner position - N30°E - 22.40 feet, with a 6' steel rail with sign 1.00 feet away.

Signed by John R. Garske Date 5/4/95
 Surveyor's Michigan License No. 28410

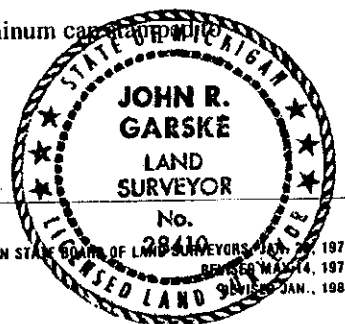

FORM APPROVED BY MICHIGAN STATE BOARD OF LAND SURVEYORS JAN. 27, 1971
 REGISTER MAY 14, 1975
 JAN., 1983