SURVEY & REMONUMENTATION

FEB 18 1994

COMMISSION

LAND CORNER RECORDATION CERTIFICATE

Filing Requirement of Act 74, Mich. P.A. 1970

Register's Office } ss.
Gogebic County }

Received for record the 30TH day of DECEMBER A. D. 19 93 at 12:20 o'clock P m., and recorded in Liber 4 of CORNERS on page 327.

Betty Sasie Deputy
Register of Deeds

Register of Deeds Stamp & File Number

For corners in Gogebic (County)

	Located In:	Corner Code ##
1. Public Land Survey	T 47N R 47W	E-2
	T ___ R ___	
	T ___ R ___	
	T ___ R ___	
2. Property Controlling	S ___ T ___ R ___	
in Section	S ___ T ___ R ___	
3. Miscellaneous	S ___ T ___ R ___	
Property in Sec.	S ___ T ___ R ___	

4. Lot No. _____ , Recorded Plat _____

5. Private Claims _____

One-quarter corner common to S-4 & S-5, T47N, R47W.

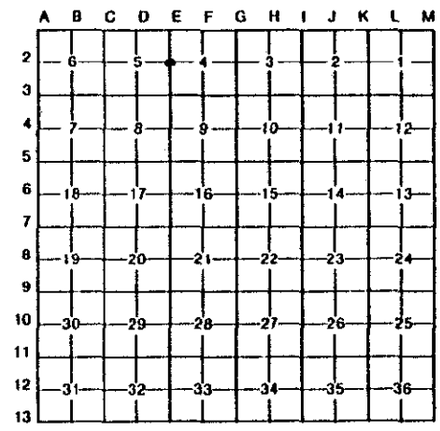

I, John R. Garske, in a field survey on December 27, 19 93, do hereby certify that under requirements of P.A. 74, Michigan P.A. of 1970, the corner points mentioned in lines 1 and 2 above were in conformance with regulations and rules therefore as required in the *current manual of survey instructions of the United States Department of the Interior, Bureau of Land* Management or by a decree of a Court of Law and/or that the corner points mentioned in lines 3, 4 and 5 above were in conformance with the rules of the Michigan Board of Land Surveyors or by a Decree of a Court of Law; established, re-established, monumented, re-monumented, recovered, found as expressed below:

NOTE: Not more than 4 corners, all in the same town and range, may be recorded on this certificate.

A. Description of original monument and accessories and/or subsequent restoration:

Survey by William Ives on August 30, 1848. Set wood post from which a 4" fir bears N70°E - 5 links and a 8" Y. birch bears S70°W - 4 links.

B. Description of corner evidence found and/or method applied in restoring or reestablishing corner:

No original evidence found. A P.K. nail was found at corner position which has been used and accepted historically at the center line/center line intersection of Nylund and Junet Roads by local residents, the County Road Commission and local surveyors. I am accepting this position as being the most probable location of the true one-quarter corner.

STATE OF MICHIGAN
JOHN R. GARSKE
LAND SURVEYOR
No. 28410
LICENSED LAND SURVEYOR

C. Description of monument for corner and accessories established to perpetuate locating the position of the corner:

Set an 8" cotton gin spike (1/2" diameter case hardened steel tapered to a point) at center line.
Center line of Junet Road and Nylund Road. Established the following bearing trees and reference objects:

P. pole #282 - N45°E - 48.82 feet
P. pole #282-A - S40°E - 55.78 feet
Reference monument - S52°W - 51.25 feet. Set 2 1/2" x 30" aluminum County Monument with a 3 1/2" stamped aluminum cap - steel sign post - 1.64 feet.
Reference monument - N46°W - 45.19 feet. Set 2 1/2" x 30" aluminum County Monument with a 3 1/2" stamped aluminum cap - steel sign post - 1.77 feet.

Signed by John R Garske Date 12/29/93

Surveyor's Michigan License No. 28410

FORM APPROVED BY MICHIGAN STATE BOARD OF LAND SURVEYORS, JAN. 28, 1971
REVISED MAY 14, 1975
REVISED JAN., 1983

FED: C-9