

**LAND CORNER RECORDATION CERTIFICATE**  
**Filing Requirement of Act 74, Mich. P.A. 1970**

For corners in

<u>Gogebic</u> (County)		Located In:	Corner Code #
1. Public Land Survey	T 47N R 47W		E-3
	T _____ R _____		_____
	T _____ R _____		_____
	T _____ R _____		_____
2. Property Controlling in Section	S _____ T _____ R _____		_____
	S _____ T _____ R _____		_____
3. Miscellaneous Property in Sec.	S _____ T _____ R _____		_____
	S _____ T _____ R _____		_____

4. Lot No. \_\_\_\_\_, Recorded Plat \_\_\_\_\_  
 5. Private Claims \_\_\_\_\_  
 Section corner common to Sections 4, 5, 8 and 9, T47N, R47W

I, John R. Garske, in a field survey on April 17, 19 95, do hereby certify that under requirements of P.A. 74, Michigan P.A. of 1970, the corner points mentioned in lines 1 and 2 above were in conformance with regulations and rules therefore as required in the current manual of survey instructions of the United States Department of the Interior, Bureau of Land Management or by a decree of a Court of Law and/or that the corner points mentioned in lines 3, 4 and 5 above were in conformance with the rules of the Michigan Board of Land Surveyors or by a Decree of a Court of Law; established, re-established, monumented, re-monumented, recovered, found as expressed below:

**NOTE: Not more than 4 corners, all in the same town and range, may be recorded on this certificate.**

**A. Description of original monument and accessories and/or subsequent restoration:**

On August 30, 1848, William Ives set a post from which a 14" B. ash bears S63°E, 15 links and a 15" B. ash - N72°W, 12 links.

**B. Description of corner evidence found and/or method applied in restoring or reestablishing corner:**

I established the corner at the centerline intersection of Junet Road and Greenfield Lane opposite an ancient fence line to the east. Measurements to known corners north, south and east were taken to confirm the corner location.

Record research on file with Register of Deeds.

**PEER GROUP APPROVED**  
*Richard L. Deaton* 7/18/95  
 COUNTY REPRESENTATIVE

**C. Description of monument for corner and accessories established to perpetuate locating the position of the corner:**

I set a 3 1/4" diameter brass cap stamped: T47N, R47W; S-4; S-5; S-8; S-9; 1995; RLS 28410, from which I established the following reference objects:  
 Power pole #4-11/05 - N17°E - 132.73 feet  
 Power pole #9-10/98 - S48°E - 36.00 feet  
 Power pole #8-96/94 - S80°W - 101.47 feet  
 A reference monument consisting of a 4 foot section of 3/4" diameter aluminum marsh rod with a 3 1/4" diameter aluminum cap stamped: County Remonumentation; T47N, R47W; R.M. 5, 4, 8, 9, 1995; R.L.S. 28410 - S43°E - 47.15'; with a 6' steel rail with sign 1.13 feet away.

Register's Office }  
 Gogebic County } ss.

Received for record the  
21<sup>st</sup> day of JULY

A. D. 1995 at 1:40 o'clock  
P m., and recorded in  
 Liber 5 of CORNERS


on page 280  
*Ramona Collins Deputy*  
 Register of Deeds

Register of Deeds Stamp & File Number

A	B	C	D	E	F	G	H	I	J	K	L	M
2	6	5	4	3	2	1						
3												
4	7	8	9	10	11	12						
5												
6	18	17	16	15	14	13						
7												
8	19	20	21	22	23	24						
9												
10	30	29	28	27	26	25						
11												
12	31	32	33	34	35	36						
13												

Signed by John R. Garske  
 Surveyor's Michigan License No. 28410

Date 5/4/95

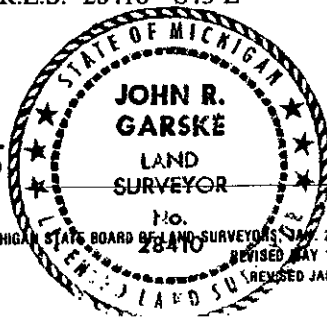

FORM APPROVED BY MICHIGAN STATE BOARD OF LAND SURVEYORS MAY 28, 1971  
 REVISED MAY 14, 1975  
 REISSUED JAN., 1983